

STATE ENGINEER
Salem, Oregon

MULT
29553

Well Record

STATE WELL NO. 1/3-5L
COUNTY Multnomah
APPLICATION NO. GR-4280
and App. No. G - 1277

OWNER: Board of County Commissioners


MAILING ADDRESS: Multnomah County Courthouse

LOCATION OF WELL: Owner's No.

CITY AND STATE: Oregon

NE 1/4 SW 1/4 Sec. 5 T. 1 N. S. R. 3 W., W.M.

Bearing and distance from section or subdivision corner Souty 77° 46' East 1960 feet ± from 1/4 Corner on West line of Section 5.

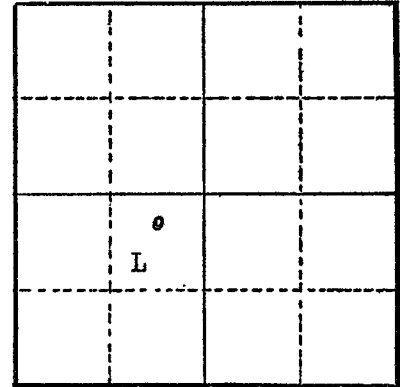

Section 5

Altitude at well 263 feet

TYPE OF WELL: Drilled Date Constructed Dec. 1941

Depth drilled 200 feet Depth cased 205 feet

CASING RECORD:

12-inch steel casing set from 0 to 115 feet
10-inch steel casing set from 115 to 205 feet

FINISH:

12 inch perforated from 60 to 90 feet
10 inch perforated from 115 to 135 feet

AQUIFERS:

sand and gravel

WATER LEVEL:

44 feet

PUMPING EQUIPMENT: Type Deming deep well turbine H.P.

Capacity 400 G.P.M.

WELL TESTS:

Drawdown 0 ft. after 400 hours G.P.M.

Drawdown ft. after hours G.P.M.

USE OF WATER Industrial Temp. °F., 19

SOURCE OF INFORMATION GR-4132

DRILLER or DIGGER

ADDITIONAL DATA:

Log Water Level Measurements Chemical Analysis Aquifer Test

REMARKS:

cemented and loose gravel - first water at 58 feet	58	58
loose water bearing gravel	26	84
coarse sand - a little gravel	36	120
cemented gravel - some water	19	139
clay	11	150
cemented gravel	50	200