

STATE ENGINEER
Salem, Oregon

MULT
2958

Well Record

STATE WELL NO. 1/3-50
COUNTY MULTNOMAH
APPLICATION NO. GR-1863

OWNER: Albert O. & Frances M. Ekstrom

MAILING ADDRESS: Rt. 1 Box 709


LOCATION OF WELL: Owner's No.

CITY AND STATE: Gresham, Oregon

SW 1/4 SE 1/4 Sec. 5 T. 1 S., R. 3 E., W.M.

Bearing and distance from section or subdivision

corner Lot 10 about center next to 195th St
200' W & 2000' N from SE corner Section 5

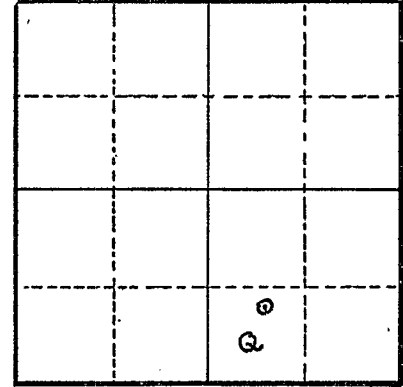

Section 5

Altitude at well

TYPE OF WELL: Drilled Date Constructed 1953

Depth drilled 290' Depth cased 290'

CASING RECORD:

10-inch

FINISH:

AQUIFERS:

gravel and sand

WATER LEVEL:

50'

PUMPING EQUIPMENT: Type Johnson Deep Well Pump H.P. 25
Capacity 750 G.P.M.

WELL TESTS:

Drawdown 100 ft. after 750 hours G.P.M.

Drawdown ft. after hours G.P.M.

USE OF WATER Industrial Temp. °F., 19

SOURCE OF INFORMATION GR-3845

DRILLER or DIGGER NA

ADDITIONAL DATA:

Log Water Level Measurements Chemical Analysis Aquifer Test

REMARKS:

Sand & Gravel