

STATE ENGINEER
Salem, Oregon

MULT
2967


Well Record

STATE WELL NO. 1/3-7R
COUNTY MULTNOMAH
APPLICATION NO. GR-2442

OWNER: Ted R. DeWitte
MAILING ADDRESS: 18040 S.E. Powell Blvd.,
CITY AND STATE: Portland 36, Oregon

LOCATION OF WELL: Owner's No. N E.
SE 1/4 SE 1/4 Sec. 7 T. 1 S, R. 3 W, W.M.

Bearing and distance from section or subdivision
corner Distance to well 290' Bearing N. 89° 43' 30"
West from corner point.

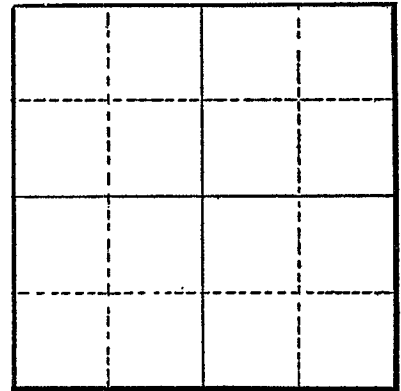

Section

Altitude at well

TYPE OF WELL: Drilled Date Constructed 1954

Depth drilled 60 Depth cased 60

CASING RECORD:

8-inch

FINISH:

Torch cut from 30' to 60'

AQUIFERS:

Gravel, clay, sand and gravel

WATER LEVEL:

30-feet

PUMPING EQUIPMENT: Type Jacuzzi Turbine H.P. 5
Capacity 80 G.P.M.

WELL TESTS:

Drawdown 20 ft. after hours Pumping 90 G.P.M.
Drawdown ft. after hours G.P.M.

USE OF WATER Irrigation Temp. °F., 19

SOURCE OF INFORMATION GR-2315

DRILLER or DIGGER

ADDITIONAL DATA:

Log Water Level Measurements Chemical Analysis Aquifer Test

REMARKS:

Gravel & clay 0' to 30'
Sand & Gravel 30' to 60'