

APR - 4 1937

APR - 4 1997 mult  
53279

Start Card # 87596 604324

(1) OWNER/PROJECT: WELL NO. 604324

Name General Delta Company Inc. 40 KIN PROP.  
Address 77 TARRYTOWN Rd. Suite 100  
City WHITE PLAINS State NY Zip 10607

**(2) TYPE OF WORK:**


- ☒ New construction      ☐ Alteration (Repair/Recondition)  
☐ Conversion      ☐ Deepening      ☐ Abandonment

### **(3) DRILLING METHOD**

- ☒ Rotary Air      ☐ Rotary Mud      ☐ Cable  
☐ Hollow Stem Auger      ☐ Other \_\_\_\_\_

#### (A) BORE HOLE CONSTRUCTION

Special Standards ☐ Yes ☒ No Depth of completed well 166 ft. \_\_\_\_\_ Land surface \_\_\_\_\_

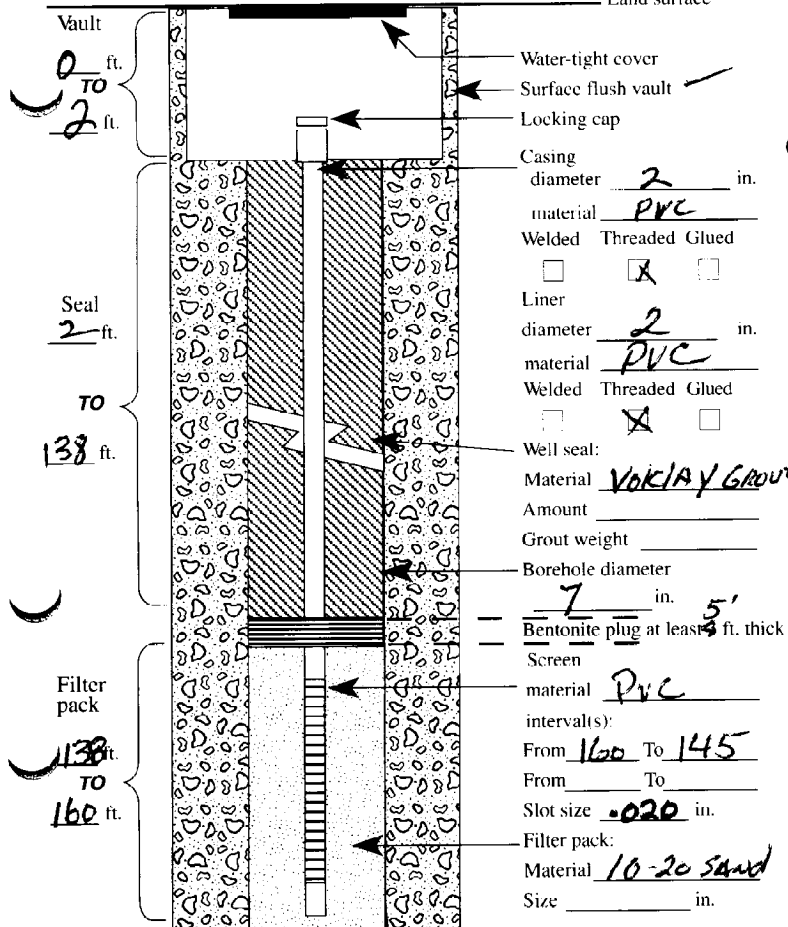

**(5) WELL TEST:**

- ☐ Pump      ☐ Bailer      ☒ Air      ☐ Flowing Artesian  
 Permeability \_\_\_\_\_ Yield 2 GPM  
 Conductivity \_\_\_\_\_ PH \_\_\_\_\_  
 Temperature of water 59 °F/C      Depth artesian flow found \_\_\_\_\_ ft.  
 Was water analysis done? ☐ Yes ☐ No  
 By whom? \_\_\_\_\_  
 Depth of strata to be analyzed. From \_\_\_\_\_ ft. to \_\_\_\_\_ ft.  
 Remarks: \_\_\_\_\_

Name of supervising Geologist/Engineer Scott Bourcy  
ORIGINAL & FIRST COPY-WATER RESOURCES DEPARTMENT

**(6) LOCATION OF WELL** By legal description

Well Location: County MULTNOMAH  
Township 1 N (N or S) Range 1 E (E or W) Section 23  
1. SE 1/4 of SE 1/4 of above section.  
2. **Either** Street address of well location 3535 NE 15th AVE.  
Portland, OR.  
**or** Tax lot number of well location 1-16

**3. ATTACH MAP WITH LOCATION IDENTIFIED.** Map shall include approximate scale and north arrow.

**(7) STATIC WATER LEVEL:**

138 Ft. below land surface. Date 8-11-96  
Artesian Pressure lb/sq. in. Date \_\_\_\_\_

**(8) WATER BEARING ZONES:**

Depth at which water was first found 138'

From	To	Est. Flow Rate	SWL
150	160	2 gpm	

**(9) WELL LOG:**

Ground elevation

[illegible]

Date started 8-10-96 Completed 8-11-96

(unbonded) Monitor Well Constructor Certification:

I certify that the work I performed on the construction, alteration, or abandonment of this well is in compliance with Oregon well construction standards. Materials used and information reported above are true to the best of my knowledge and belief.

knowledge and belief.

Signed Wayne Huff MWC Number 10409  
Date 8-11-96

(bonded) Monitor Well Constructor Certification:

I accept responsibility for the construction, alteration, or abandonment work performed on this well during the construction dates reported above. All work performed during this time is in compliance with Oregon well construction standards. This report is true to the best of my knowledge and belief.

Signed [Signature] MWC Number 10024  
Date 8-11-96  
SECOND COPY-CONSTRUCTION THIRD COPY-CUSTOMER

ORIGINAL &amp; FIRST COPY-WATER RESOURCES DEPARTMENT

RECEIVED

APR - 4 1997

WATER RESOURCES DEPT.  
SALEM, OREGON  
NE FREMONT STREET

0 25 50  
APPROXIMATE SCALE IN FEET



**AGRA**

Earth & Environmental  
7477 S.W. Tech Center Drive  
Portland, OR, U.S.A. 97223-8025

W.O.	21-08438-00
DESIGN	PDE
DRAWN	GW
DATE	AUG 1996
SCALE	APPROX. 1"=25'

SITE AND EXPLORATION MAP SHOWING  
GEOPROBE LOCATIONS - AUGUST 13, 1996

FIGURE 4

- LEGEND**
- GP6 GEOPROBE SAMPLE NUMBER AND LOCATION
  - MW-1 MONITORING WELL NUMBER AND LOCATION

COX'S DRY  
CLEANERS

PACIFIC POWER  
AND LIGHT

PAVED  
PARKING

SEWER LINE  
UTILITY CORRIDOR

NW NATURAL GAS  
UTILITY CORRIDOR

NE 14TH AVENUE

SIDEWALK

GP15 LANDSCAPING

GP11 MW-1  
GP10 CB1  
GP12  
GP13 GP14  
CB7

DRAIN

DOWNFALL