

## GEOTECHNICAL HOLE REPORT

MULT 59465

Received date 11/04/1999

(as required by OAR 690-240-035)

**(1) OWNER/PROJECT**Hole No.  
Co. Job No. **B-1**

Name **ODC**  
 Street **1100 SW GLISAN STE 300**  
 City **PORTLAND** State **OR** Zip **97202**

**(2) TYPE OF WORK**

- ☒ New ☐ Alter (Recondition) ☐ Alter (Repair)  
☐ Deepening ☒ Abandonment

**(3) CONSTRUCTION**

- ☐ Rotary Air ☐ Hand Auger ☐ Hollow Stem Auger  
☐ Rotary Mud ☐ Cable Tool ☒ Push Probe Other

**(4) TYPE OF HOLE**

- ☒ Uncased Temporary ☐ Cased Permanent  
☐ Uncased Permanent ☐ Slope Stability Other

**(5) USE OF HOLE****(6) BORE HOLE CONSTRUCTION**Special Standards ☐ Depth of completed well **35** ft.

HOLE	Diameter	From	To			
	5.00	0.00	35			
SEAL	From	To	Material	Amount	Seal Grout Weight	Units
	0.00	35.00	Bentonite	7.00		\$

Backfill placed from ft. TO ft. Material  
 Filter pack placed from ft. TO ft. Size in.

**(7) CASING/SCREEN**Screen ☐**(8) WELL TEST**

Permeability Yield GPM  
 Conductivity PH  
 Temperature of water °F/C Depth artesian flow found ft.  
 Was water analysis done? ☐  
 By Whom?  
 Depth of strata to be analyzed. From ft. to ft.  
 Remarks  
 Name of supervising Geologist/Engineer

**(9) LOCATION OF HOLE By legal description**

County **Multnomah** Latitude Longitude  
 Township **1.00 N** Range **1.00 E**  
 Section **34** NW 1/4 NW 1/4  
 Tax lot Lot Block Subdivision  
 Legal desc:

Street Address of Well (or nearest address)

**NW 9TH AND LOVEJOY**

MAP with location identified must be attached

**(10) STATIC WATER LEVEL**

Ft. below land surface. Date  
 Artesian Pressure lb/sq. in. Date

**(11) SUBSURFACE LOG**

Ground Elevation ft.

Material	From	To	SWL
FILL	0	15	
SILTS	15	35	

Date started **10/22/1999** Completed **10/22/1999****(12) ABANDONMENT LOG**

Date started Completed

**Professional Certification**


(to be signed by a licensed water supply or monitoring well constructor, or registered geologist or civil engineer).

I accept responsibility for the construction, alteration, or abandonment work performed on this well during the construction dates reported above. All work performed during this time is in compliance with Oregon geotechnical hole construction standards. This report is true to the best of my knowledge and belief.

License or Registration Number **10452**Signed By **LARRY INSELMAN**

Date

Affiliation **GEO TECH EXPLORATIONS**

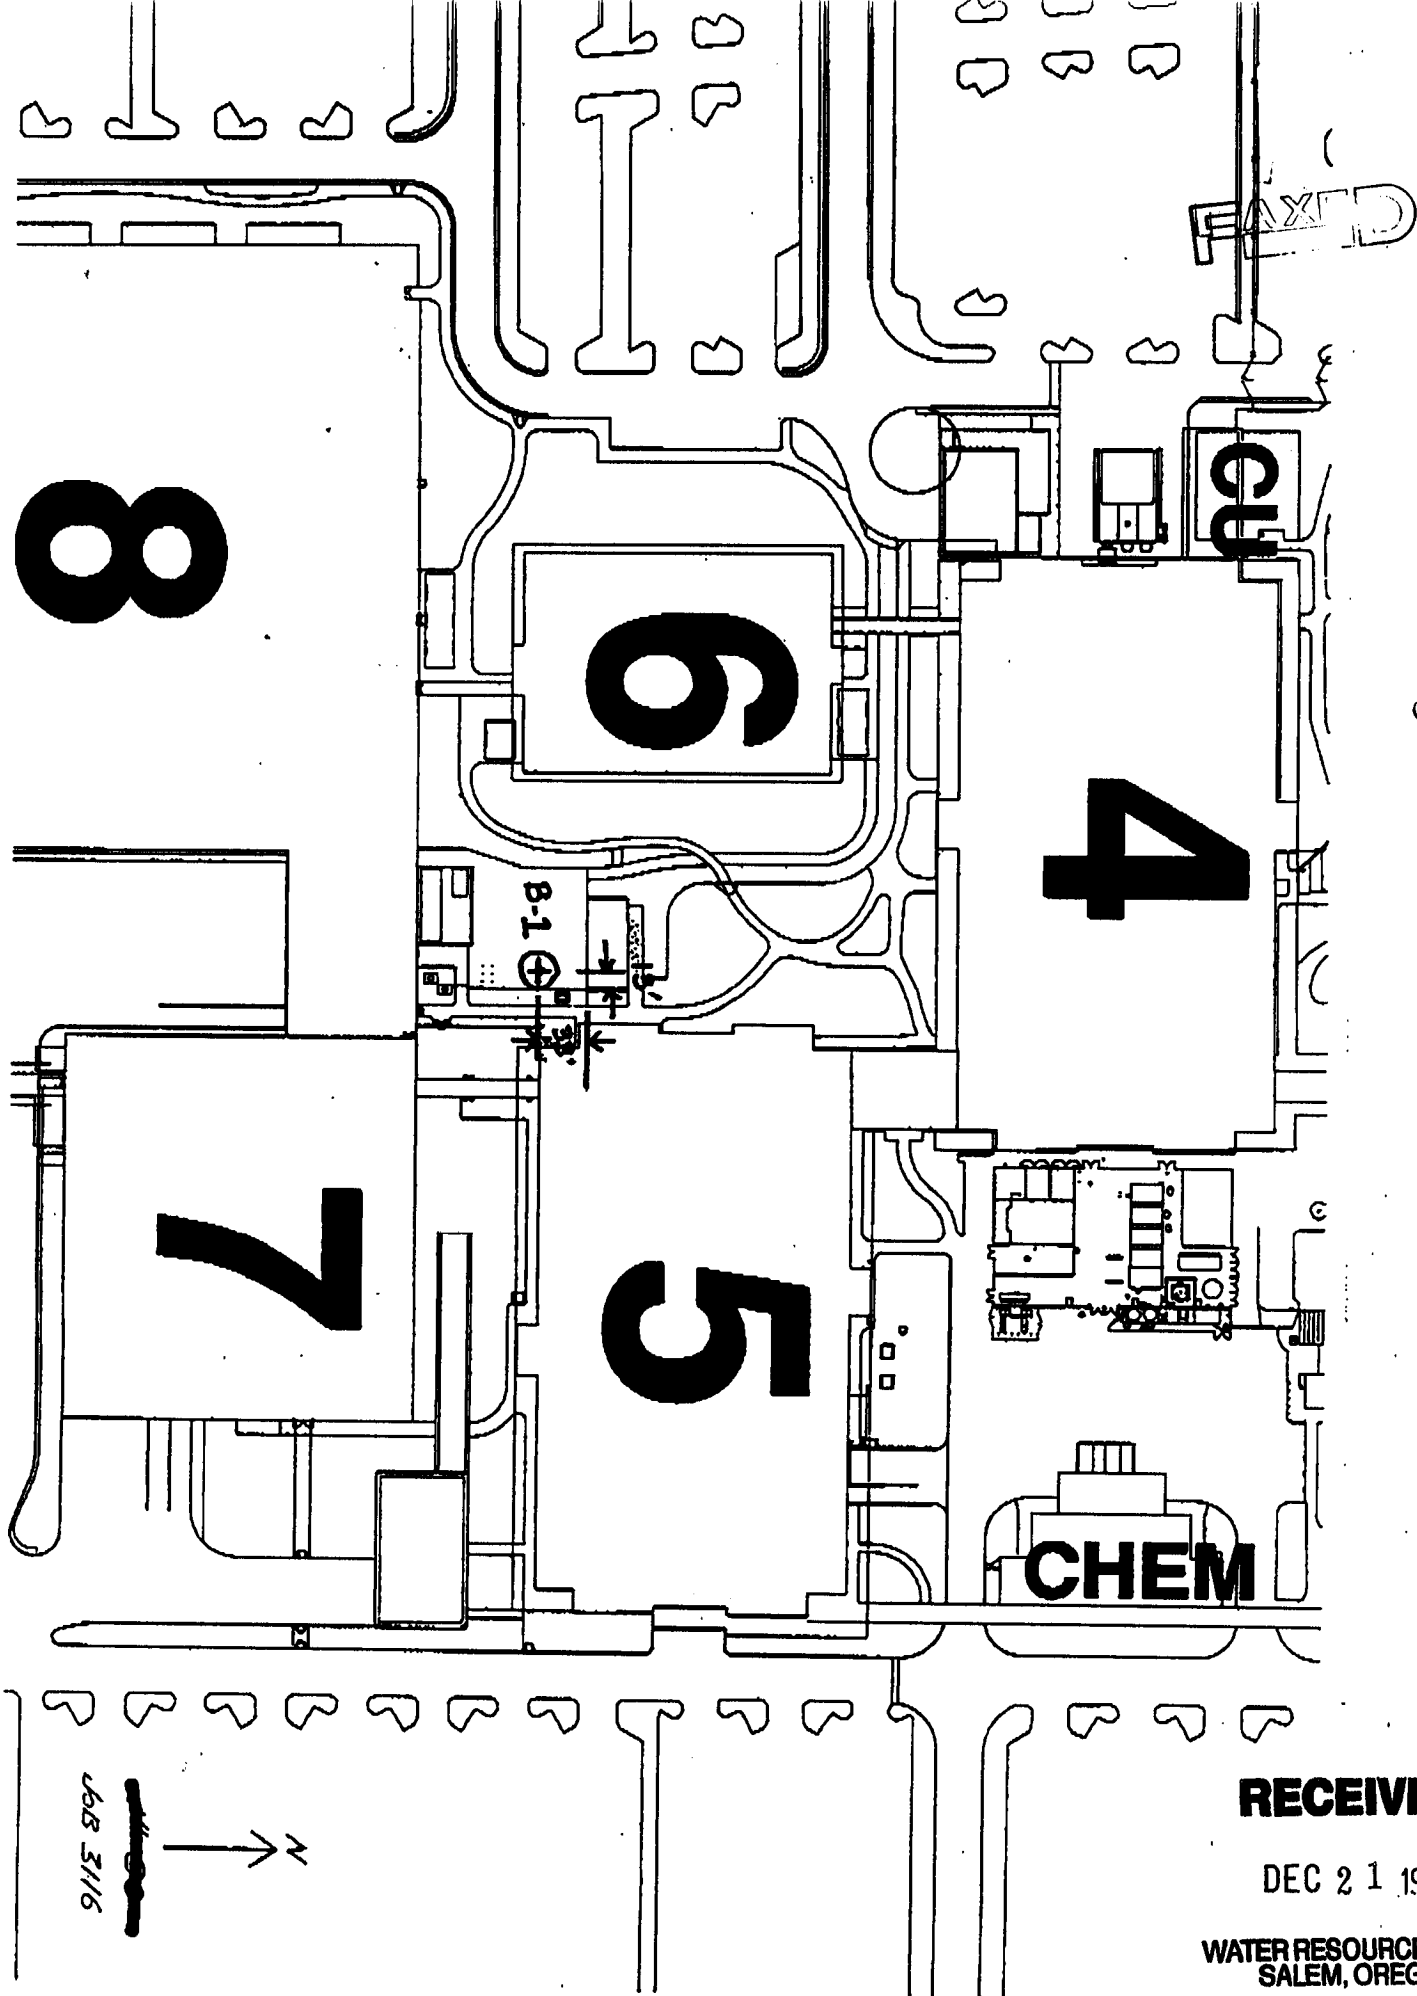

multimedia  
5-9465

**RECEIVED**

DEC 21 1999

WATER RESOURCES DEPT.  
SALEM, OREGON