


SITE MAP

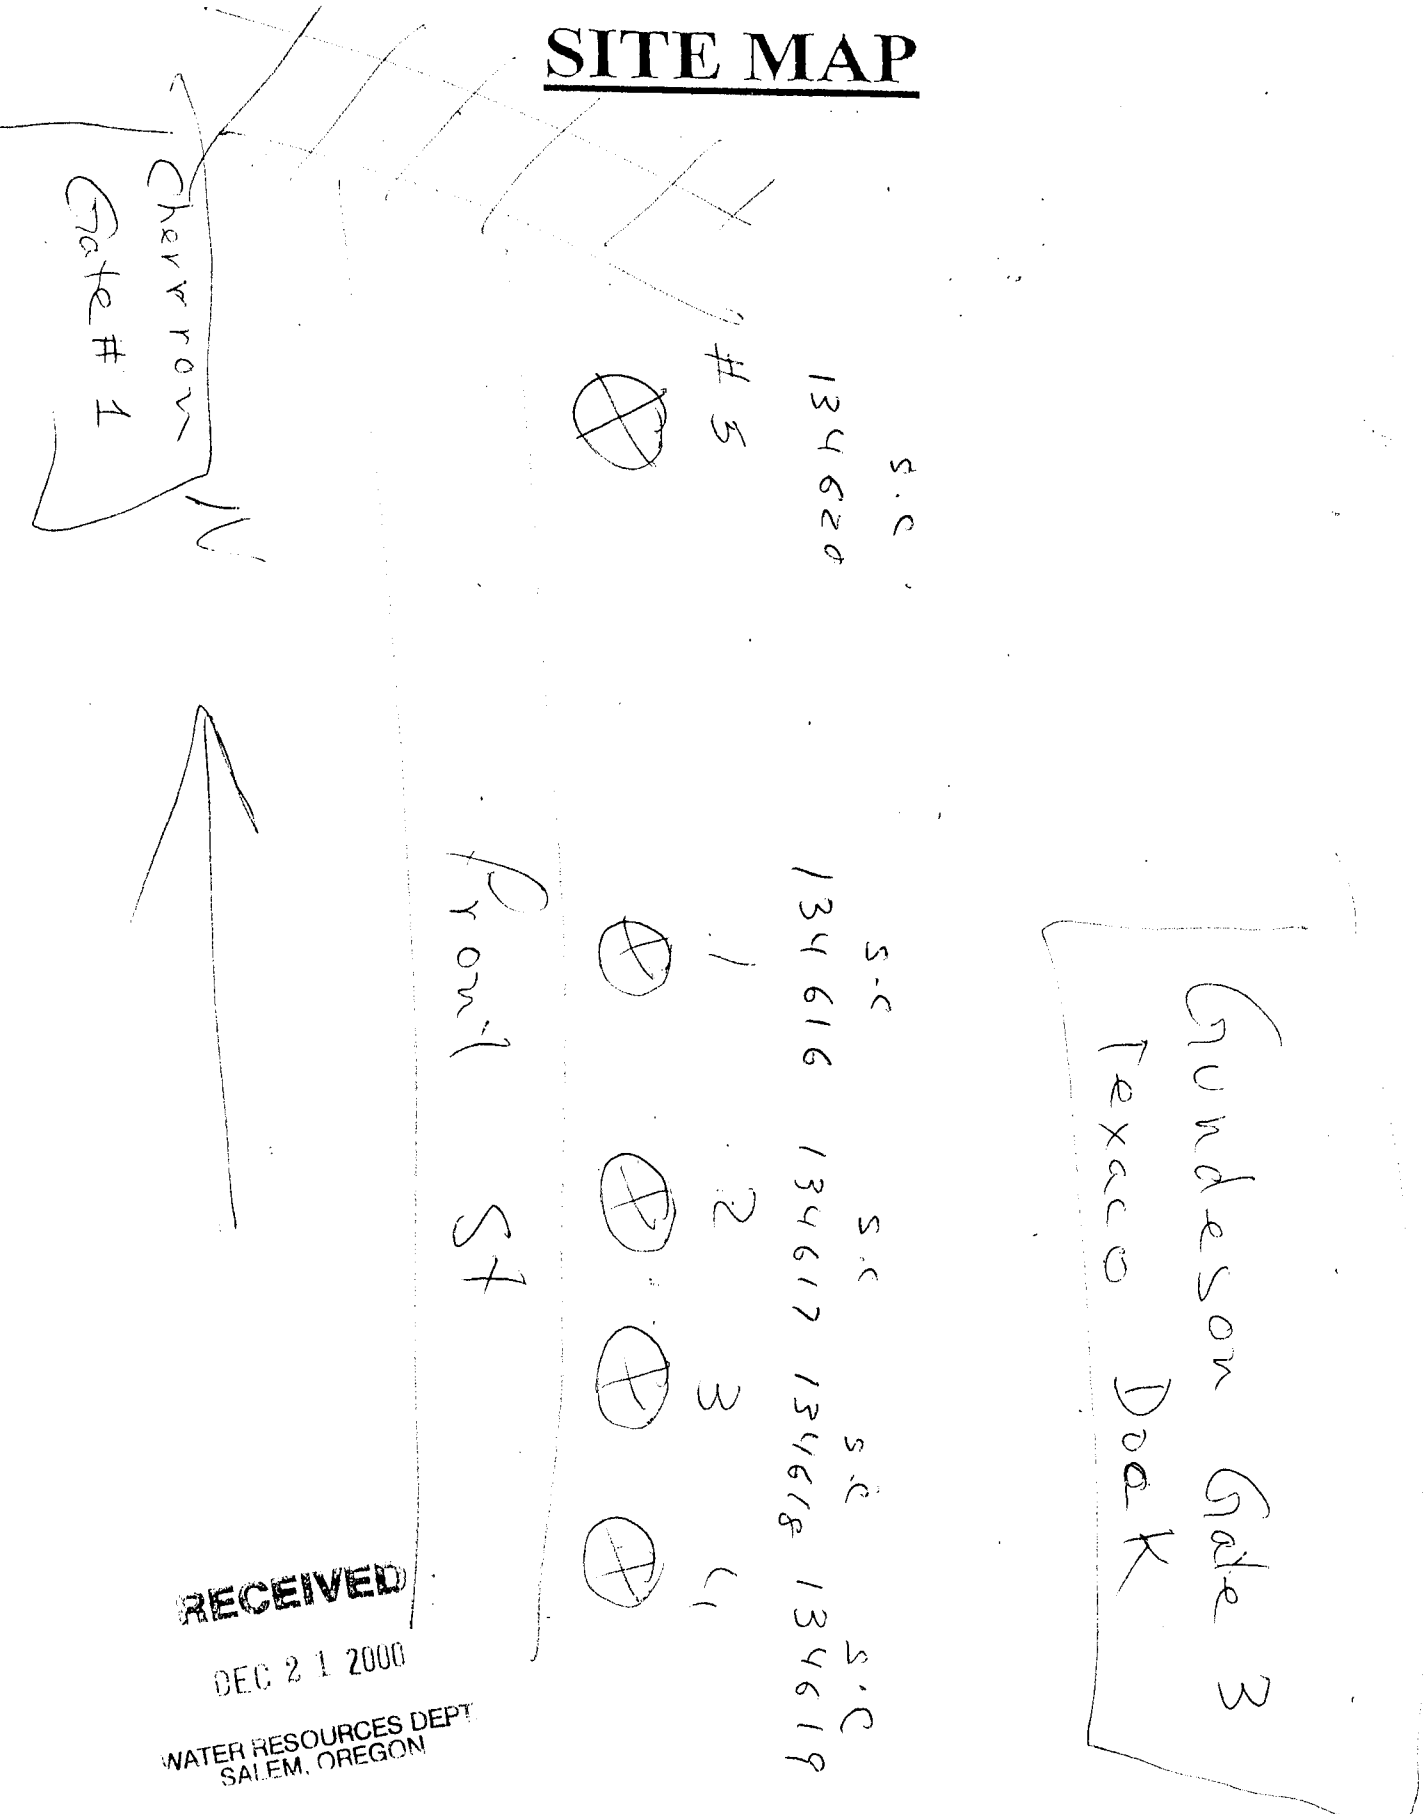

RECEIVED

DEC 21 2000

WATER RESOURCES DEPT
SALEM, OREGON