

Instructions for completing this report are on the last page of this form.

WELL NO.

Name City of Portland Bureau of Env. Services
Address 1120 SW 5th Ave RM 1000 Attn: Katie Thompson
City Portland, State OR Zip 97204-1972

(2) TYPE OF WORK:


☒ New construction ☐ Alteration (Repair/Recondition)
☐ Conversion ☐ Deepening ☐ Abandonment

(3) DRILLING METHOD

☒ Rotary Air ☐ Rotary Mud ☐ Cable
☐ Hollow Stem Auger ☐ Other _____

(4) BORE HOLE CONSTRUCTION

Special Standards ☒ Yes ☐ No Depth of completed well 156 ft.

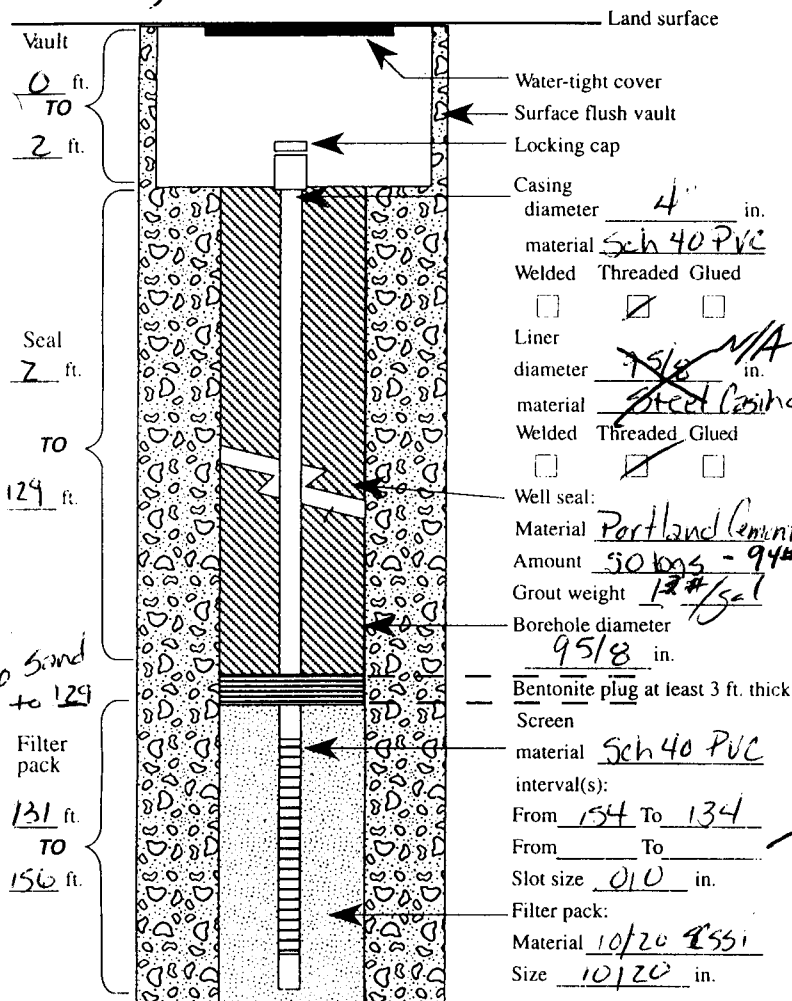

(5) WELL TEST:

☐ Pump ☐ Bailer ☐ Air ☐ Flowing Artesian

Permeability	Yield	GPM
--------------	-------	-----

Conductivity _____ PH _____

Temperature of water 56 °C Depth artesian flow found _____ ft.

Was water analysis done? ☐ Yes ☐ No

By whom?

Depth of strata to be analyzed. From NA ft. to _____ ft.

Remarks:

Name of supervising Geologist/Engineer

(6) LOCATION OF WELL By legal description

Well Location: County Multnomah
Township 15 (N or S) Range 2E (E or W) Section 19

1. NE 1/4 of NE 1/4 of above section.

2. **Either** Street address of well location Brentwood Park
or Tax lot number of well location 1700

3. ATTACH MAP WITH LOCATION IDENTIFIED. Map shall include approximate scale and north arrow.

(7) STATIC WATER LEVEL:

126.3 Ft. below land surface. Date 1/22/01
Artesian Pressure lb/sq. in. Date

(8) WATER BEARING ZONES:

Depth at which water was first found 131'

From	To	Est. Flow Rate	SWL
131	156		126.3

(9) WELL LOG:

Ground elevation

Material	From	To	SWL
brown silty sand	0	9	
sand w/ minor gravel	9	130	
gravels w/ minor sand	130	156	126.3
RECEIVED FEB 11 9 2001 WATER RESOURCES DEPT. SALEM, OREGON			
2' sample: 154-156'			

Date started 1/18/01 Completed 1/23/01

(unbonded) Monitor Well Constructor Certification:

I certify that the work I performed on the construction, alteration, or abandonment of this well is in compliance with Oregon well construction standards. Materials used and information reported above are true to the best knowledge and belief.


Signed 1/11/2/1 MWC Number 10420
Date 2/5/01

(bonded) Monitor Well Constructor Certification:

I accept responsibility for the construction, alteration, or abandonment work performed on this well during the construction dates reported above. All work performed during this time is in compliance with Oregon well construction standards. This report is true to the best of my knowledge and belief.

Signed [Signature] MWC Number 10024
Date 2/6/01
SECOND COPY-CONSTRUCTOR THIRD COPY-CUSTOMER

DATE	1/11/01	
BY	WJH	
CHECKED BY	WJH	
APPROVED BY	WJH	
REVISIONS		
NO.	DATE	DESCRIPTION
1	1/11/01	INITIAL Dwg 07/11/01

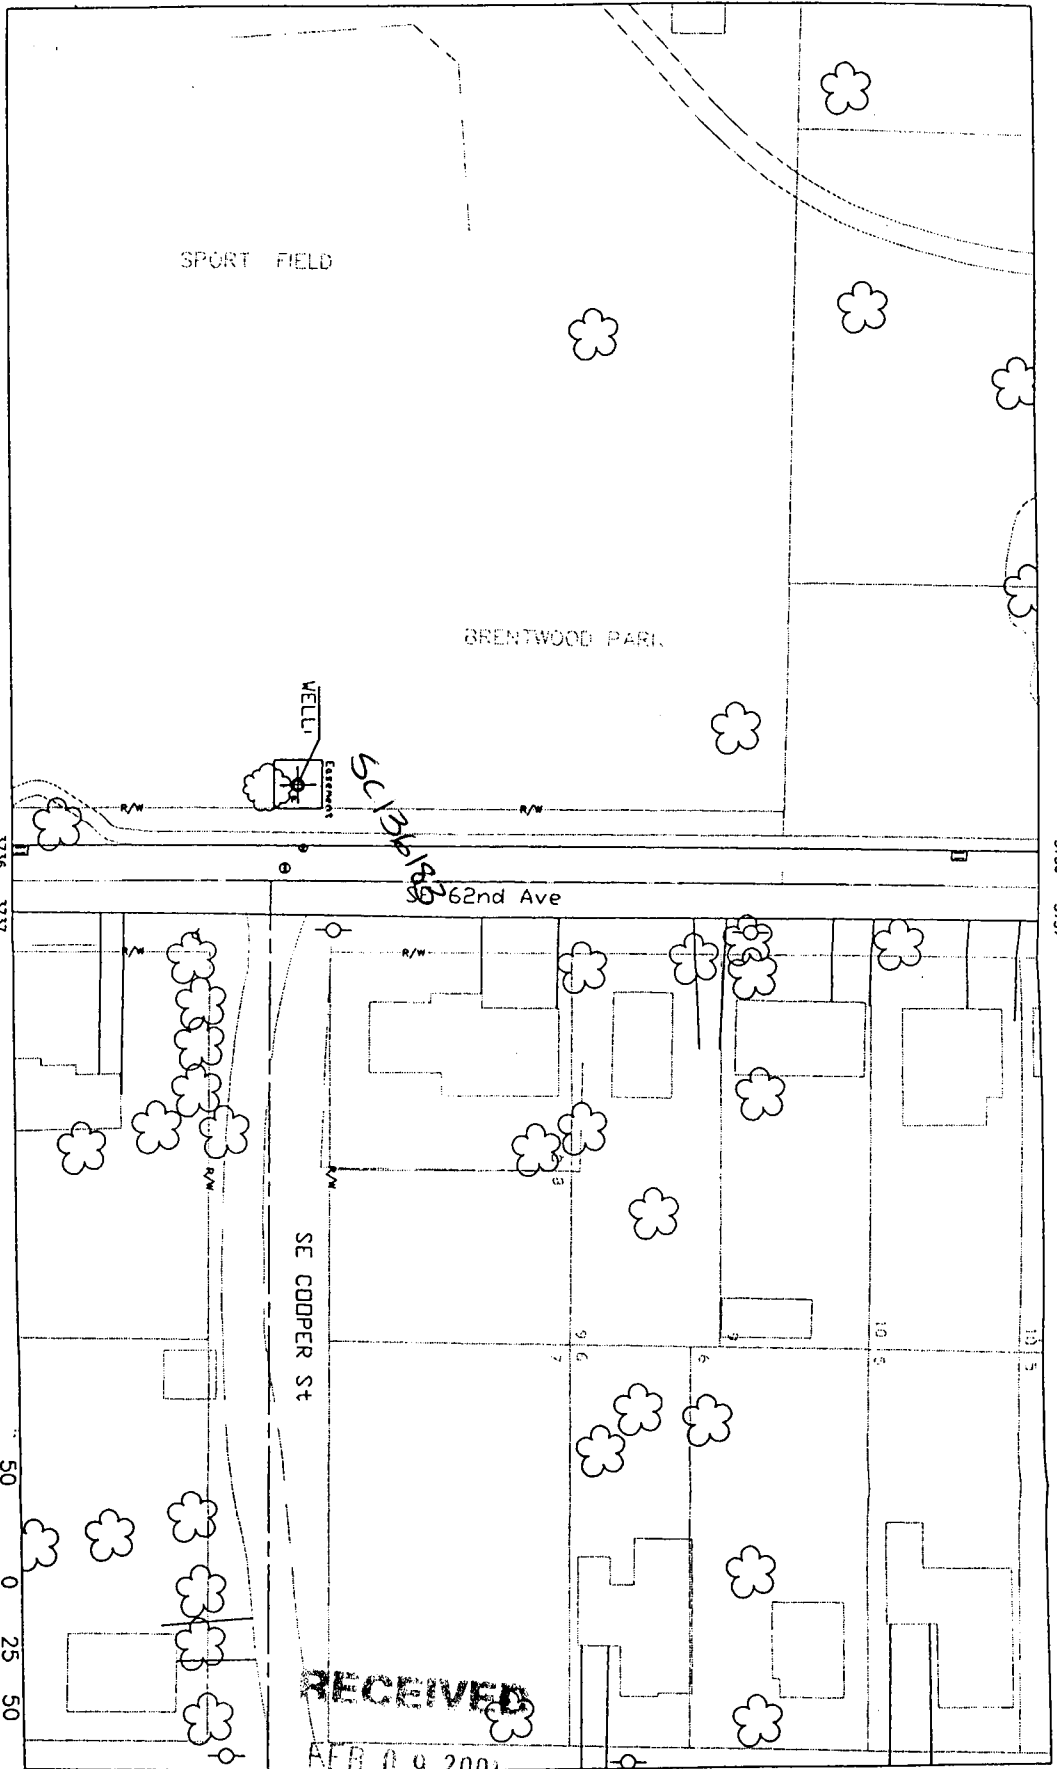

CITY OF PORTLAND
ENVIRONMENTAL SERVICES



JOHNSON CREEK BASIN
GROUNDWATER MONITORING WELLS
BRENTWOOD PARK
LOCATION PLAN FOR SITE 4
S.E. 62nd Ave. & S.E. COOPER ST

RECEIVED
FEB 09 2001

WATER RESOURCES DEPT
SALEM, OREGON

Site #4

DATE: 1/11/01
BY: WJH
C4