MULT 72092

STATE OF OREGON
WATER SUPPLY WELL REPORT
(as required by ORS 537.765)

Instructions for completing this report are on the last page of this form.

WELL I.D. # L 41164
START CARD # W 160983

(1) LAND OWNER Well Number _____
Name Colwood Limited Partnership
Address 7313 NE Columbia Blvd.
City Portland State OR Zip 97218

(2) TYPE OF WORK
☒ New Well ☐ Deepening ☐ Alteration (repair/recondition) ☐ Abandonment

(3) DRILL METHOD:
☐ Rotary Air ☐ Rotary Mud ☒ Cable ☐ Auger
☐ Other _____

(4) PROPOSED USE:
☐ Domestic ☐ Community ☐ Industrial ☒ Irrigation
☐ Thermal ☐ Injection ☐ Livestock ☐ Other _____

(5) BORE HOLE CONSTRUCTION:
Special Construction approval ☐ Yes ☒ No Depth of Completed Well 95'6" ft.
Explosives used ☐ Yes ☒ No Type _____ Amount _____

HOLE Diameter	From	To	Material	SEAL From	To	Sacks or pounds
16"	0	20	Holeplug			18 sacks
12"	20	95'6"				

How was seal placed: Method ☐ A ☐ B ☐ C ☐ D ☐ E
☒ Other Poured while surface casing removed
Backfill placed from _____ ft. to _____ ft. Material _____
Gravel placed from 62 ft. to 95'6" ft. Size of gravel 6x9 sand

(6) CASING/LINER:

	Diameter	From	To	Gauge	Steel	Plastic	Welded	Threaded
Casing:	12"	+ 2	71'6"	.375	☒	☐	☒	☐
Riser pipe	8"	61'6"	69'6"	.277	☒	☐	☒	☐
Tail pipe	8"	89'6"	95'6"	.277	☒	☐	☒	☐
					☐	☐	☐	☐
Liner:					☐	☐	☐	☐
					☐	☐	☐	☐

Drive Shoe used ☐ Inside ☒ Outside ☐ None
Final location of shoe(s) 95'6"

(7) PERFORATIONS/SCREENS:
☐ Perforations Method _____
☒ Screens Type Stainlesssteel Material _____

From	To	Slot size	Number	Diameter	Tele/pipe size	Casing	Liner
69'6"	89'6"	40			8"	☐	☐
						☐	☐
						☐	☐
						☐	☐

(8) WELL TESTS: Minimum testing time is 1 hour
☒ Pump ☐ Bailer ☐ Air ☐ Flowing Artesian

Yield gal/min	Drawdown	Drill stem at	Time
620	12'8"		1 hr.

Temperature of water 54.7° Depth Artesian Flow Found _____
Was a water analysis done? ☐ Yes By whom _____
Did any strata contain water not suitable for intended use? ☐ Too little
☐ Salty ☐ Muddy ☐ Odor ☐ Colored ☐ Other _____
Depth of strata: _____

(9) LOCATION OF WELL by legal description:
County Multnomah Latitude _____ Longitude _____
Township 1N N or S Range 2E E or W. WM.
Section 17 NW 1/4 SW 1/4
Tax Lot 300 Lot _____ Block _____ Subdivision _____
Street Address of Well (or nearest address) 7313 NE Columbia Blvd.

(10) STATIC WATER LEVEL:
14.2½ ft. below land surface. Date 12/19/03
Artesian pressure _____ lb. per square inch Date _____

(11) WATER BEARING ZONES:
Depth at which water was first found 53'

From	To	Estimated Flow Rate	SWL
53	96	600	14

(12) WELL LOG:
Ground Elevation _____

Material	From	To	SWL
Top Soil	0	5	
Brown sandy clay	5	18	
Brown silty sand mucky	18	25	
Grey silty sand (water)	25	53	
Grey gravel sand (water)	53	75	14
Brown gravel sand (water)	75	90	14
Brown grey gravel sand tighter (little water)	90	96	14

RECEIVED
JAN 21 2004
WATER RESOURCES DEPT.
SALEM, OREGON

Date started 12/9/03 Completed 12/19/03

(unbonded) Water Well Constructor Certification:
I certify that the work I performed on the construction, alteration, or abandonment of this well is in compliance with Oregon water supply well construction standards. Materials used and information reported above are true to the best of my knowledge and belief.
WWC Number 1321
Signed Jerry Johnson Date _____

(bonded) Water Well Constructor Certification:
I accept responsibility for the construction, alteration, or abandonment work performed on this well during the construction dates reported above. All work performed during this time is in compliance with Oregon water supply well construction standards. This report is true to the best of my knowledge and belief.
WWC Number 1445
Signed Ron Cayman Date 1-16-04

ORIGINAL – WATER RESOURCES DEPARTMENT FIRST COPY – CONSTRUCTOR SECOND COPY – CUSTOMER

MULT 72092

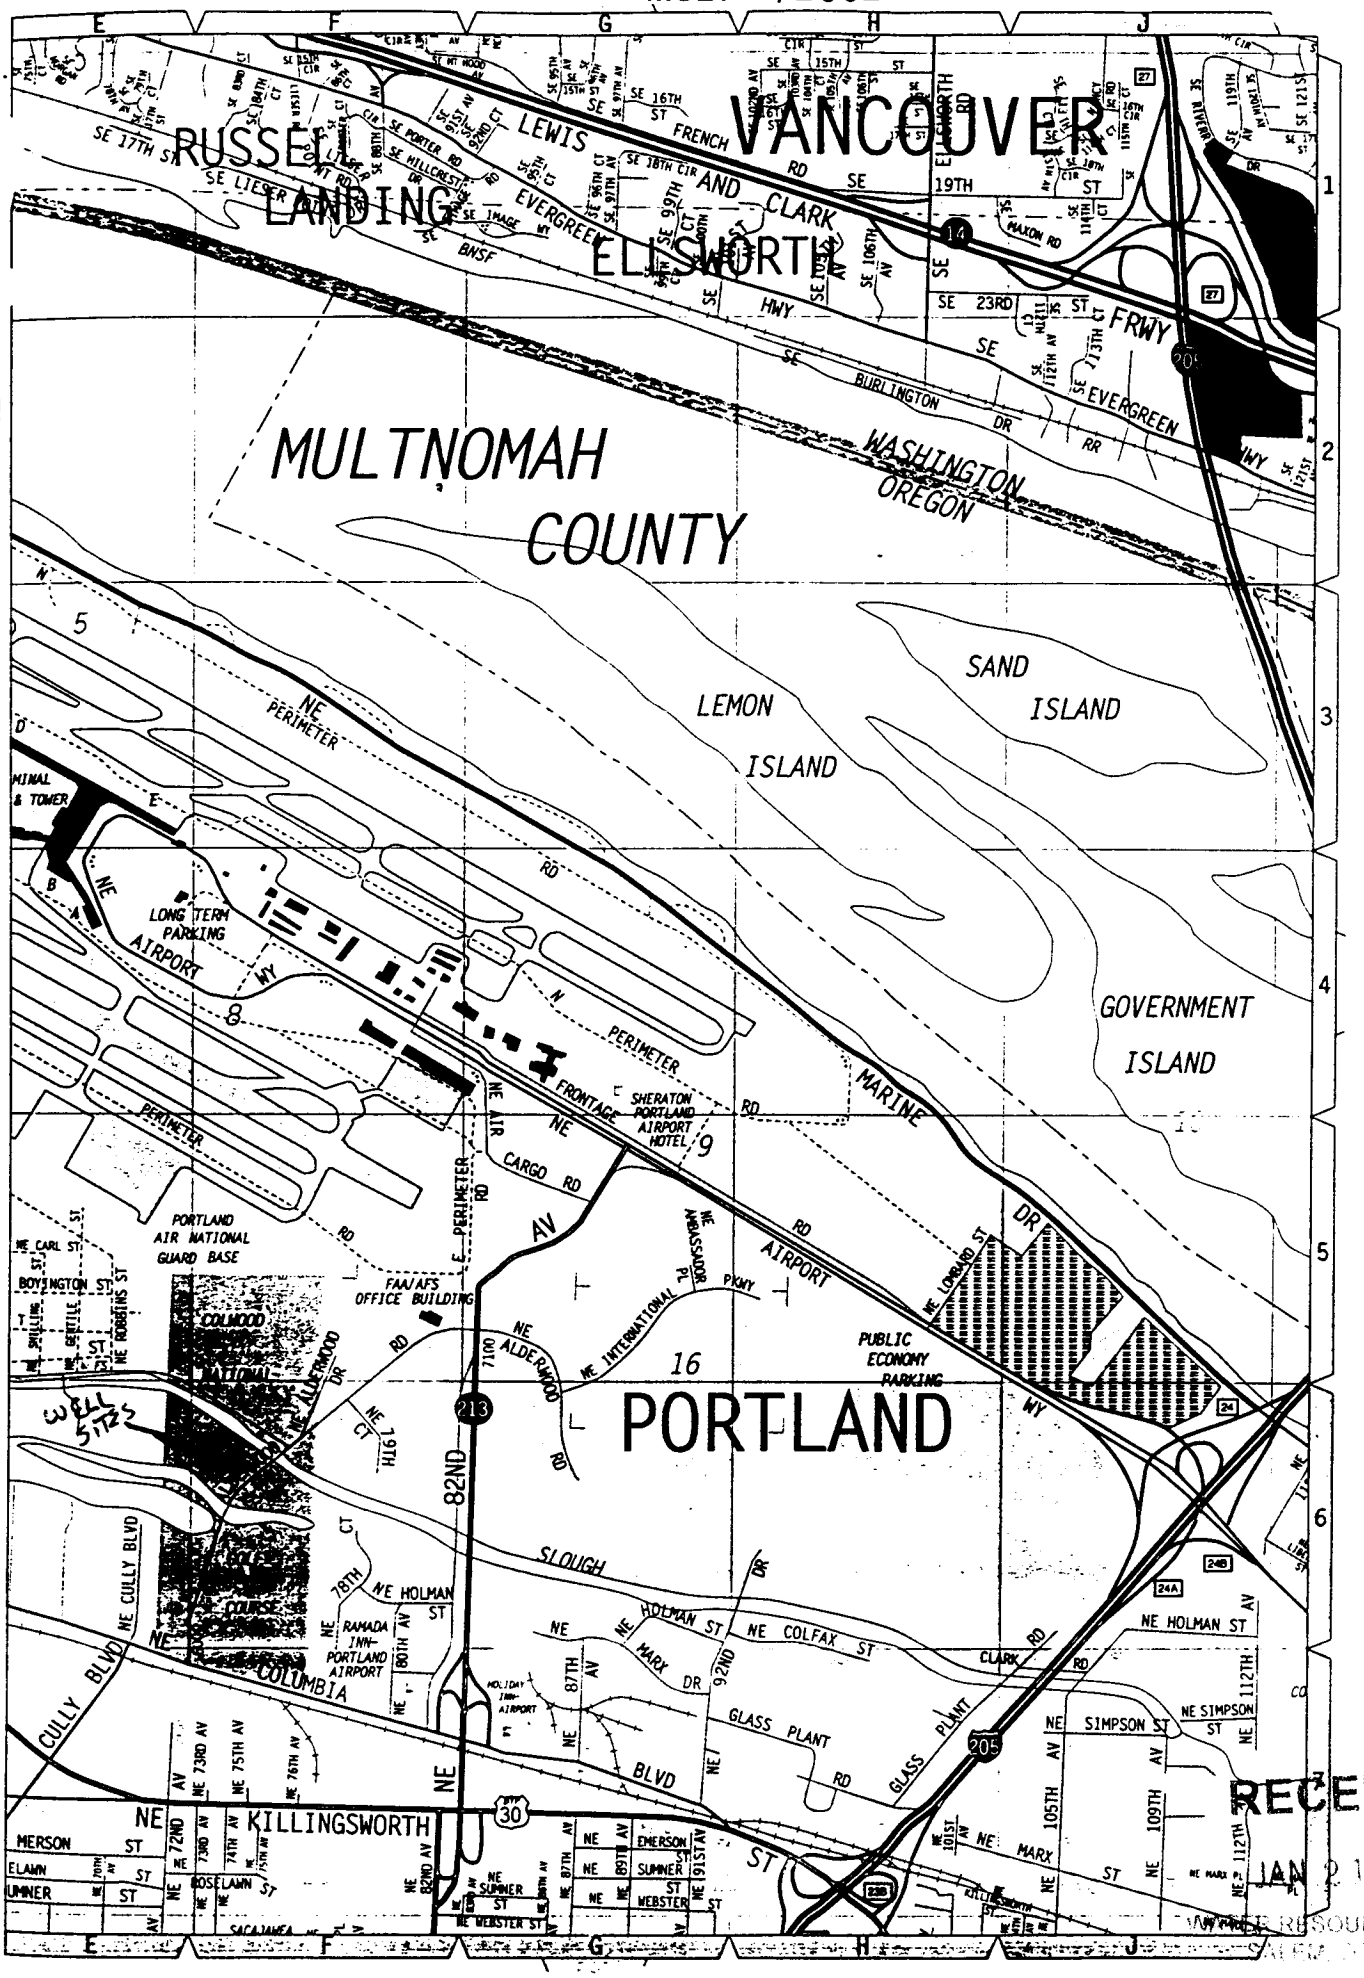

RECEIVED
JAN 21 2004
WATER RESOURCES DEPARTMENT