




**MULT 72119**

As Built for Cascade Well No. 4  
Rockwood Water PUD  
MULT 72119 AMENDED DIA

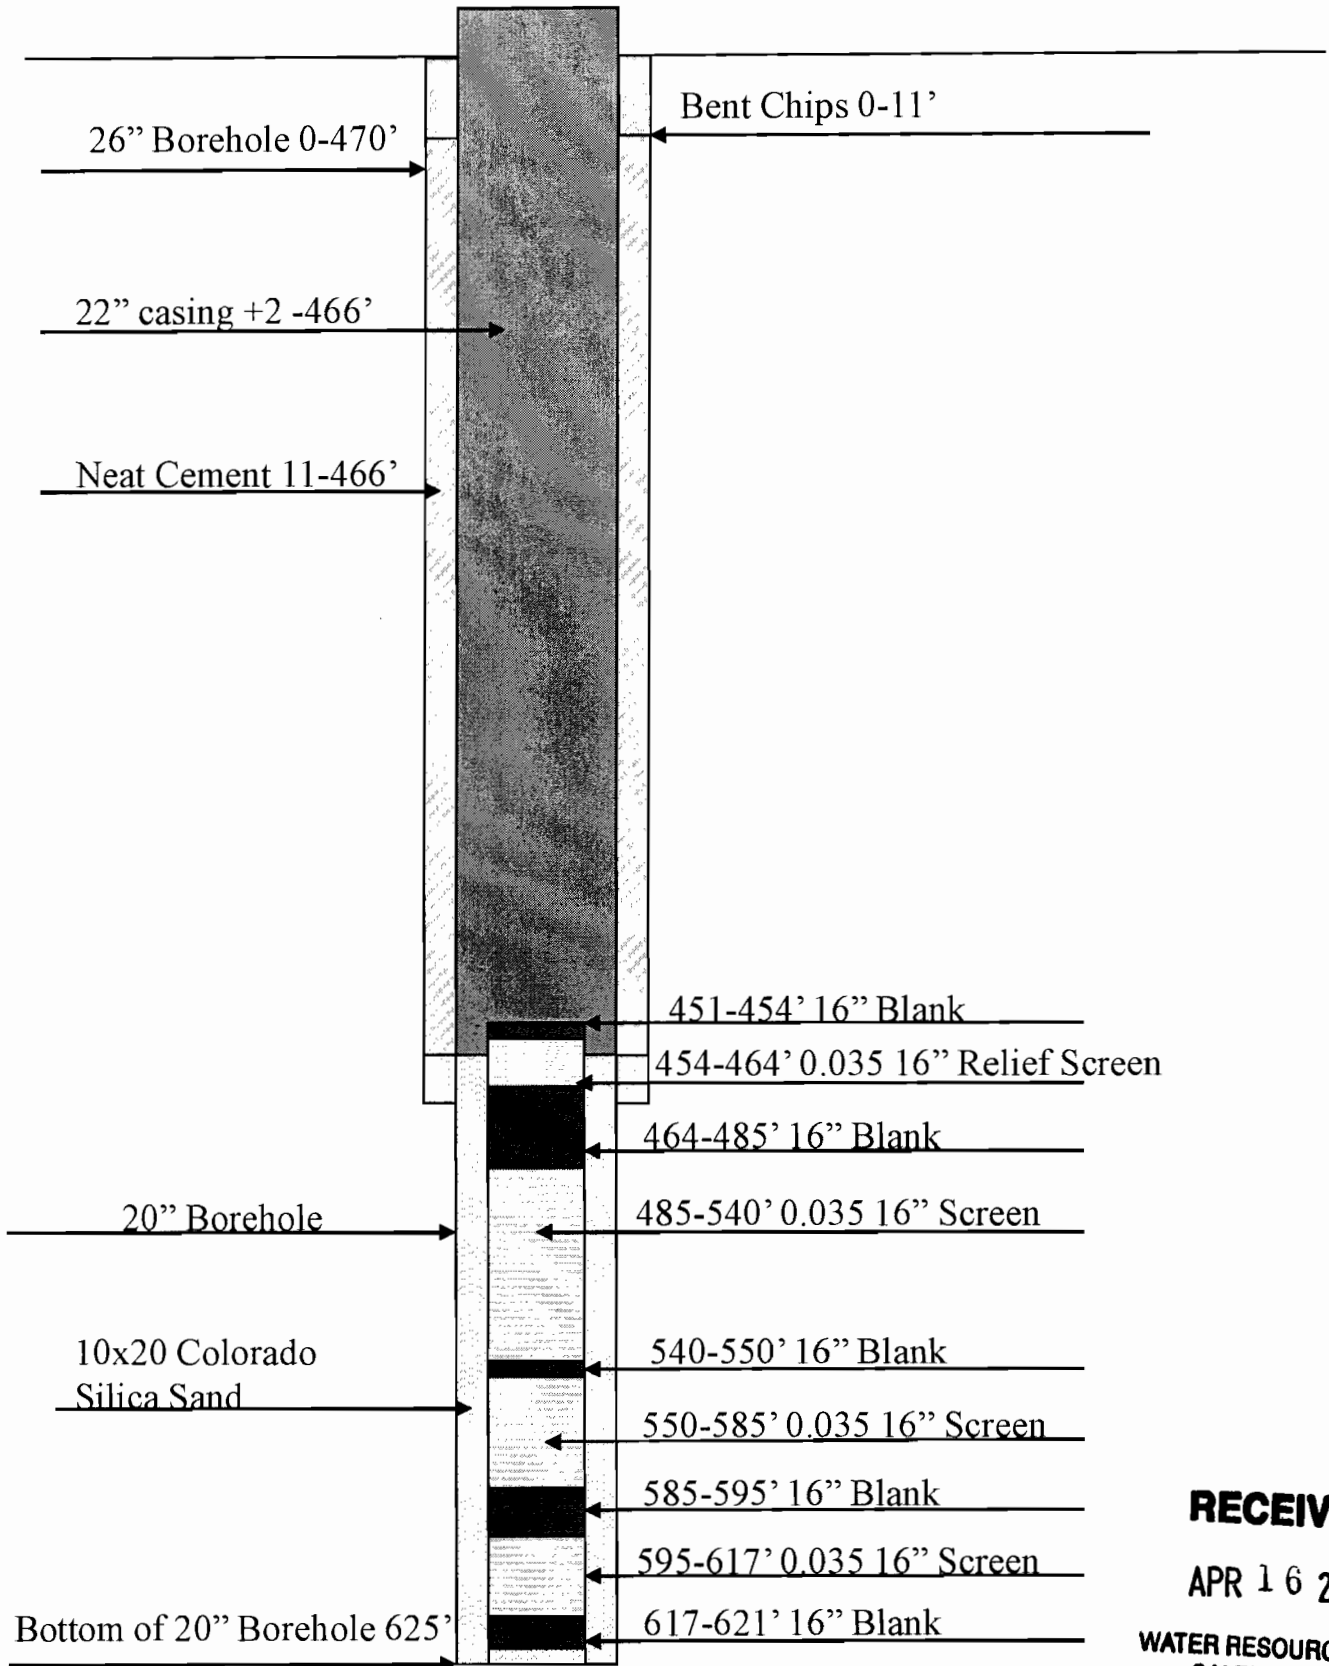

**RECEIVED**

APR 16 2012

WATER RESOURCES DEPT  
SALEM, OREGON





Geo-Tech Explorations, Inc.  
 19700 SW Teton  
 Tualatin, OR 97062  
 Ph: (503) 692-6400, Fax: (503) 692-4759

Well Name: Cascade Well No. 4  
 Start Card #: 160370  
 Label #: L68016

Material Description	From:	To:
Topsoil with gravels	0	6
Gravels	6	120
Gravels with some cementation	120	138
Brown silt with gravels	138	178
Green silt with gravels	178	186
Green and brown silt with gravels	186	190
Grey to green silt with some gravels	190	280
Brown silt with small gravels	205	208
Siltstone hard, grey	218	226
Grey siltstone med hard	226	265
Gravels, small to sand	265	287
Gravels, Hard	287	302
Gravels with some cementation	302	320
Gravels, Hard, Cemented	320	330
Gravels, Hard, loose	330	336
Gravels, hard with grey silt	336	361
Gravels with brown and grey silt	361	380
Gravels, hard with some cementation	380	386
Gravels, hard with grey silt	386	404
Silt, grey to green with gravels	404	416
Gravels, hard	416	420
Silt to clay, green	420	432
Brown silt	432	441
Gravels with brown silt	441	450
Sandy silt, brown	450	472
Gravels, Hard, Cemented	472	478
Brown clay	478	480
Black sand, cemented	480	502
Gravels, cemented	502	532
Gravels with loose sands	532	536
Sand and gravels	536	540
Grey sand with some gravels	540	544
Grey sand, fine	544	551
Dark grey sand, medium	551	600
Gravels, large with wood and sand	600	605
Sand and gravels	605	624
Wood	624	625

**RECEIVED**

FEB 05 2004

WATER RESOURCES DEPT  
 SALEM, OREGON