

STATE ENGINEER  
Salem, Oregon

MULT  
865

# Well Record

STATE WELL NO. 1N/1W-23M(1)  
COUNTY Multnomah  
APPLICATION NO. GR-416

OWNER: Northwest Memorial Gardens


MAILING ADDRESS: 4101 N. W. Skyline Blvd.

LOCATION OF WELL: Owner's No.

CITY AND STATE: Portland, Oregon

NW 1/4 SW 1/4 Sec. 23 T. 1 N. S., R. 1 E. W., W.M.

Bearing and distance from section or subdivision corner 1113.15 feet South & 78° 58 1/2' East of West 1/4 corner Section 23

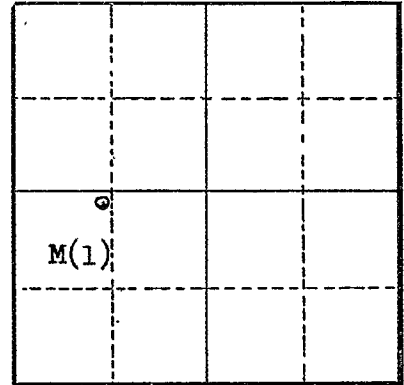

Altitude at well 1100

TYPE OF WELL: Drilled Date Constructed June 30 1954

Depth drilled 541 Depth cased 201

Section 23

### CASING RECORD:

12 inch

### FINISH:

### AQUIFERS:

### WATER LEVEL:

PUMPING EQUIPMENT: Type Bersford submersible H.P. 42

Capacity 210 G.P.M.

### WELL TESTS:

Drawdown ft. after hours G.P.M.

Drawdown ft. after hours G.P.M.

USE OF WATER Irrigation 108 Temp. °F., 19

SOURCE OF INFORMATION GR-416

DRILLER or DIGGER

### ADDITIONAL DATA:

Log  Water Level Measurements Chemical Analysis Aquifer Test

### REMARKS: