

STATE ENGINEER
Salem, Oregon

MULT
901

Well Record


STATE WELL NO. 1N/1W 36E(1)
COUNTY Multnomah
APPLICATION NO.

OWNER: Portland Gas and Coke Co. MAILING ADDRESS:

LOCATION OF WELL: Owner's No. CITY AND STATE:

..... 1/4 1/4 Sec. T. N. E. S., R. W., W.M.

Bearing and distance from section or subdivision corner

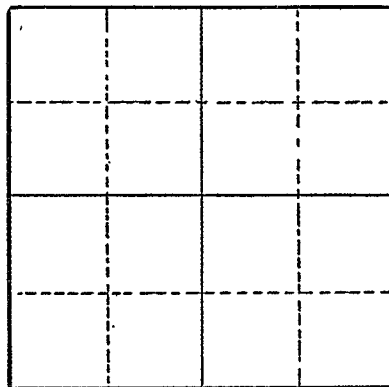

Section 36

Altitude at well 750

TYPE OF WELL: drilled Date Constructed

Depth drilled 421 Depth cased 65

CASING RECORD: 12 inch.

FINISH:

AQUIFERS: Basalt from 406 to 412 ft.

WATER LEVEL: 265 ft. below land surface.

PUMPING EQUIPMENT: Type Capacity G.P.M. H.P.

WELL TESTS: Drawdown ft. after hours G.P.M. Drawdown ft. after hours G.P.M.

USE OF WATER ind. Temp. °F., 19

SOURCE OF INFORMATION USGS

DRILLER or DIGGER

ADDITIONAL DATA: Log Water Level Measurements Chemical Analysis Aquifer Test

REMARKS: Pumped 350 gpm with 35 ft. of drawdown.