

STATE ENGINEER
Salem, Oregon

MULT
902

Well Record

STATE WELL NO. 1N/1W-36N(1)
COUNTY Multnomah
APPLICATION NO. GR-426

OWNER: W. Strowger


MAILING ADDRESS: 100 N. W. Tuality Way

LOCATION OF WELL: Owner's No.

CITY AND STATE: Portland, Oregon

SW 1/4 SW 1/4 Sec. 36 T. 1 N. S. R. 1 E. W., W.M.

Bearing and distance from section or subdivision corner About 630' East and 40' North of SW cor. Section 36

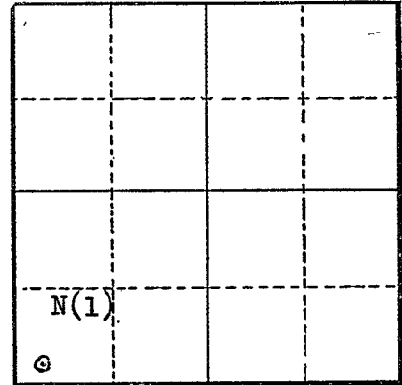

Altitude at well 780

TYPE OF WELL: drilled Date Constructed 10-15-49

Depth drilled 432 Depth cased Section 36

CASING RECORD:

6 inch

FINISH:

AQUIFERS:

do.

WATER LEVEL:

341

PUMPING EQUIPMENT: Type Piston H.P. 3
Capacity 9 G.P.M.

WELL TESTS:

Drawdown ft. after hours G.P.M.
Drawdown ft. after hours G.P.M.

USE OF WATER Irrigation 4 acres Temp. °F., 19

SOURCE OF INFORMATION U.S.G.S. GR-426

DRILLER or DIGGER A. L. Ziesing, Portland, Oregon

ADDITIONAL DATA:

Log Water Level Measurements Chemical Analysis Aquifer Test

REMARKS:

