

STATE ENGINEER
Salem, Oregon

MULT
912

Well Record

GR- 1047

STATE WELL NO. 1N/1-1E(1)
COUNTY Multnomah
APPLICATION NO. GR- 1086

OWNER: Russell Towboat & Moorage Co.

MAILING

ADDRESS: 2434 N.E. Marine Dr.

LOCATION OF WELL: Owner's No.


CITY AND

STATE: Portland, Oregon

SW 1/4 NW 1/4 Sec. 1 T. 1 N. 1 R. 1 E. W.M.

Bearing and distance from section or subdivision

corner 700' E. & 2150' S. from NW cor. Sec. 1.

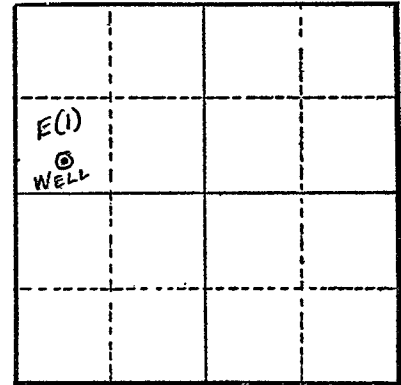

Section 1

Altitude at well 12 ft. ±

TYPE OF WELL: Drilled Date Constructed 1952

Depth drilled 154 ft. Depth cased 154 ft.

CASING RECORD:

10 inch

FINISH:

AQUIFERS:

WATER LEVEL:

10 ft.

PUMPING EQUIPMENT: Type Pump, Pipe & Power H.P. 10

Capacity 250 G.P.M.

WELL TESTS:

Drawdown None ft. after 500 hours G.P.M.

Drawdown ft. after hours G.P.M.

USE OF WATER Irrigation Temp. °F. 19

SOURCE OF INFORMATION G.R. Record

DRILLER or DIGGER Steinman Bros.

ADDITIONAL DATA:

Log N.A. Water Level Measurements Chemical Analysis Aquifer Test

REMARKS:

Irrigation of 60.0 acres.