

STATE ENGINEER  
Salem, Oregon

MULT  
942

# Well Record

STATE WELL NO. 1N/1-7N  
COUNTY Multnomah  
APPLICATION NO. GR-4270

OWNER: McCormick & Baxter Geosoting Co.


MAILING ADDRESS: P. O. Box 3344

LOCATION OF WELL: Owner's No. \_\_\_\_\_

CITY AND STATE: Portland, Oregon

SW 1/4 SW 1/4 Sec. 7 T. 1 N., R. 1 W., W.M.

Bearing and distance from section or subdivision  
corner North 13° 38.6' West 4215.6 feet to NW  
Corner, Section 7.

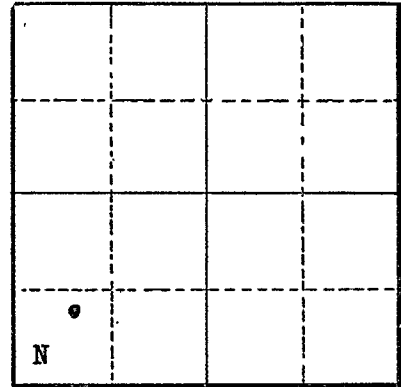

Altitude at well 20 feet

TYPE OF WELL: Drilled Date Constructed Sept. 1945

Depth drilled 130 feet Depth cased 130 feet

Section 7

### CASING RECORD:

12-inch casing set from 0 to 130 feet

### FINISH:

casing perforated from 65 to 124 feet  
size of perforations not known

### AQUIFERS:

sand, gravel, and clay

### WATER LEVEL:

23 feet

PUMPING EQUIPMENT: Type Lane Bowler Deep Well Turbine Pump H.P. \_\_\_\_\_  
Capacity 750 G.P.M.

### WELL TESTS:

Drawdown 0 ft. after \_\_\_\_\_ hours 1200 G.P.M.  
Drawdown 8 ft. after \_\_\_\_\_ hours 1300 G.P.M.

USE OF WATER Industrial Temp. \_\_\_\_\_ °F., 19 \_\_\_\_\_

SOURCE OF INFORMATION GR-4121

DRILLER or DIGGER R. J. Strasser Drilling Co. Portland, Oregon

### ADDITIONAL DATA:

Log  Water Level Measurements \_\_\_\_\_ Chemical Analysis \_\_\_\_\_ Aquifer Test \_\_\_\_\_

### REMARKS:

dredged sand 12 to 118 cemented gravel 13 to 12  
silt, clay and very fine sand 48 to 70 gravel with a little water 5 to 7  
coarse sand with water 24 to 46 cemented gravel 7 to 0  
gravel with clay binder 21 to 25

