

STATE ENGINEER
Salem, Oregon


MULT
964

Well Record

STATE WELL NO. 1N/1-100
COUNTY Multnomah
APPLICATION NO. GR-4275

OWNER: Blue Bell Potato Chip Co. MAILING ADDRESS: 100 NE Farragut Street
Division of Sunshine Biscuits, Inc. CITY AND STATE: Portland, Oregon
LOCATION OF WELL: Owner's No. _____

SW $\frac{1}{4}$ SE $\frac{1}{4}$ Sec. 10 T. 1 S., R. 1 W., W.M.
Bearing and distance from section or subdivision
corner 1050 feet East and 900 feet North from
the S $\frac{1}{4}$ Corner, Section 10.

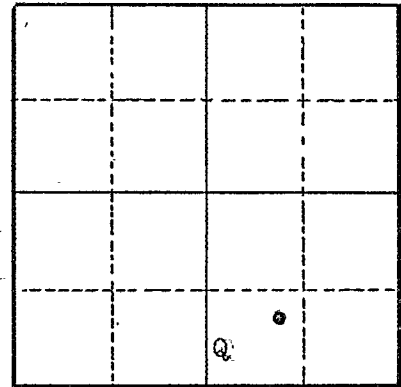

Altitude at well 50 feet

TYPE OF WELL: Drilled Date Constructed June, 1954
Depth drilled 287 feet Depth cased _____

CASING RECORD:

12-inch casing

FINISH:

AQUIFERS:

WATER LEVEL:

PUMPING EQUIPMENT: Type Jane and Bowler Vertical turbine pump H.P. _____
Capacity 650 G.P.M.

WELL TESTS:

Drawdown _____ ft. after _____ hours 500 G.P.M.
Drawdown _____ ft. after _____ hours _____ G.P.M.

USE OF WATER Manufacturing Temp. _____ °F. _____, 19____

SOURCE OF INFORMATION GR-4127

DRILLER or DIGGER A. M. Janssen Well Drilling Co. Aloha, Oregon

ADDITIONAL DATA:

Log (NA) Water Level Measurements _____ Chemical Analysis _____ Aquifer Test _____

REMARKS: