

STATE ENGINEER
Salem, Oregon

Well Record **POLK 1020** STATE WELL NO. 6/3W - 8D
COUNTY POLK
APPLICATION NO. GR-2219

OWNER: Ralph J. Chance


MAILING ADDRESS: Rt. 1, Box 483

LOCATION OF WELL: Owner's No. _____

CITY AND STATE: Salem, Oregon

NW $\frac{1}{4}$ NW $\frac{1}{4}$ Sec. 8 T. 6 N. 1 S., R. 3 W., W.M.

Bearing and distance from section or subdivision corner 350' E. and 390' S.

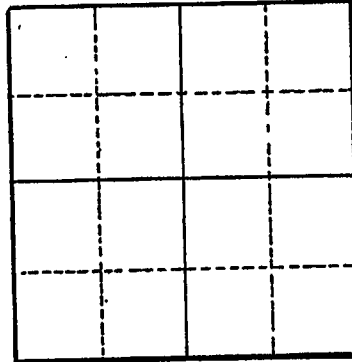

Section _____

Altitude at well _____

TYPE OF WELL: Drilled Date Constructed 1952

Depth drilled 206 Depth cased 94 206

CASING RECORD:

8-Inch
6-Inch

FINISH:

Perforations from 94 to 206

AQUIFERS:

Clay

WATER LEVEL:

20-Feet

PUMPING EQUIPMENT: Type Berkeley Jet H.P. 35
Capacity 60 G.P.M.

WELL TESTS:
Drawdown 32 ft. after _____ hours Pumping 32 G.P.M.
Drawdown _____ ft. after _____ hours _____ G.P.M.

USE OF WATER Irrigation Temp. _____ °F. _____, 19____

SOURCE OF INFORMATION GR-2124
DRILLER or DIGGER John C. Miller

ADDITIONAL DATA:

Log X Water Level Measurements _____ Chemical Analysis _____ Aquifer Test _____

REMARKS:

