

STATE ENGINEER
Salem, Oregon

Well Record **Polk** STATE WELL NO. **6/3W-19L**
COUNTY **Polk**
1078 APPLICATION NO. **GR-3129**

OWNER: Roscoe E. and Louise A. Clark


MAILING ADDRESS: Route 1, Box 456

LOCATION OF WELL: Owner's No. _____

CITY AND STATE: Salem, Oregon

NE 1/4 SW 1/4 Sec. 19 T. 6 N S., R. 3 E W., W.M.

Bearing and distance from section or subdivision corner 5048' E. and 1227' S.

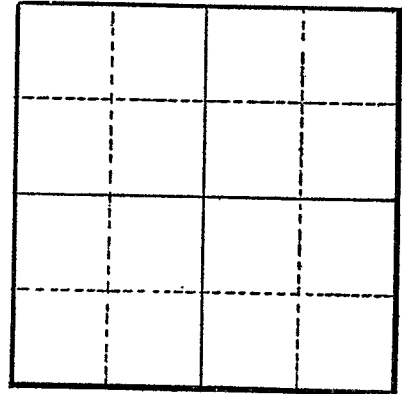

Section _____

Altitude at well _____

TYPE OF WELL: Drilled Date Constructed 1953

Depth drilled 70' Depth cased 70'

CASING RECORD:

10"

FINISH:

cut with torch 4 holes per foot for about 8 feet

AQUIFERS:

WATER LEVEL:

20'

PUMPING EQUIPMENT: Type Turbine Type _____ H.P. 10
Capacity 250 G.P.M.

WELL TESTS:

Drawdown 20 ft. after _____ hours pumping 250 G.P.M.

Drawdown _____ ft. after _____ hours _____ G.P.M.

USE OF WATER irrigation Temp. _____ °F. _____, 19

SOURCE OF INFORMATION GR-2935

DRILLER or DIGGER Wilcox of McMinnville, Oregon

ADDITIONAL DATA:

Log _____ Water Level Measurements _____ Chemical Analysis _____ Aquifer Test _____

REMARKS: