


STATE ENGINEER  
Salem, Oregon

Well Record *Polk* STATE WELL NO. *6/3W-19P*  
COUNTY *Polk*  
*1079* APPLICATION NO. *GR-3700*

OWNER: *Russel L. Hicks*  
MAILING ADDRESS: *Route 1, Box 455*  
CITY AND STATE: *Salem, Oregon*

LOCATION OF WELL: Owner's No. \_\_\_\_\_  
*SE 1/4 SW 1/4 Sec. 19 T. 6 S., R. 3 W., W.M.*  
Bearing and distance from section or subdivision  
corner *950' N. & 550' W. from S $\frac{1}{4}$  cor. Sec. 19*

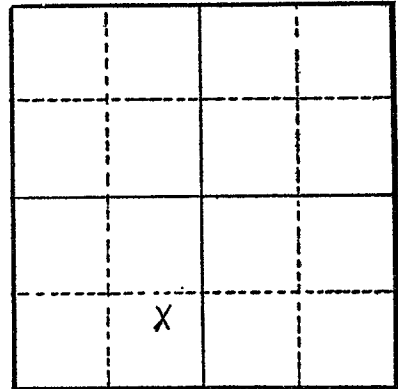

Altitude at well \_\_\_\_\_

TYPE OF WELL: *Drilled* Date Constructed *Feb., 1953*  
Depth drilled *90 feet* Depth cased *85 feet*

Section *19*

CASING RECORD:

*8 inch steel casing set from pump to 85 feet*

FINISH:

AQUIFERS:

WATER LEVEL:

*20 feet below surface*

PUMPING EQUIPMENT: Type *Berkley turbine* H.P. *10*  
Capacity *200* G.P.M.

WELL TESTS:

Drawdown *80* ft. after \_\_\_\_\_ hours *240* G.P.M.  
Drawdown \_\_\_\_\_ ft. after \_\_\_\_\_ hours *200* G.P.M.

USE OF WATER *Irrigation* Temp. \_\_\_\_\_ °F., *19*

SOURCE OF INFORMATION *Well Registration Statement*

DRILLER or DIGGER *F. L. Wilcox*

ADDITIONAL DATA:

Log \_\_\_\_\_ Water Level Measurements \_\_\_\_\_ Chemical Analysis \_\_\_\_\_ Aquifer Test \_\_\_\_\_

REMARKS: