

STATE ENGINEER
Salem, Oregon

Well Record

Polk
10078

STATE WELL NO. 6/3W-20B
COUNTY POLK
APPLICATION NO. GR-2758

OWNER: Irving S. Hanger


MAILING ADDRESS: Rt. 1, Box 463

LOCATION OF WELL: Owner's No.

CITY AND STATE: Salem, Oregon

NW 1/4 NE 1/4 Sec. 20 T. 6 N. S. R. 3 E. W., W.M.

Bearing and distance from section or subdivision corner 1750' W. and 850' S.

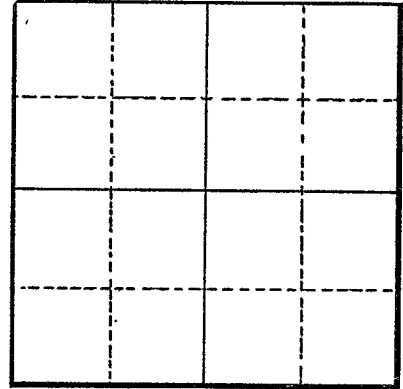

Section

Altitude at well

TYPE OF WELL: drilled Date Constructed 1941

Depth drilled 24 Depth cased 22

CASING RECORD:

8-inch

FINISH:

AQUIFERS:

WATER LEVEL:

5-feet

PUMPING EQUIPMENT: Type Pacific Centrifugal H.P. 7 1/2

Capacity 180 G.P.M.

WELL TESTS:

Drawdown ft. after hours G.P.M.

Drawdown ft. after hours G.P.M.

USE OF WATER irrigation Temp. °F., 19.

SOURCE OF INFORMATION GR-2606

DRILLER or DIGGER

ADDITIONAL DATA:

Log Water Level Measurements Chemical Analysis Aquifer Test

REMARKS: