

STATE ENGINEER
Salem, Oregon

Well Record

*Polk
log*

STATE WELL NO. 6/3W-20B
COUNTY Polk
APPLICATION NO. GR-1657

GR- 1608

OWNER: Chester E. Lee

MAILING

ADDRESS: Rt. 1, Box 461

LOCATION OF WELL: Owner's No. _____


CITY AND

STATE: Salem, Oregon

NW 1/4 NE 1/4 Sec. 20 T. 6 S., R. 3 W., W.M.

Bearing and distance from section or subdivision

corner 1200' S. & 2400' W. from NE Sec. 20

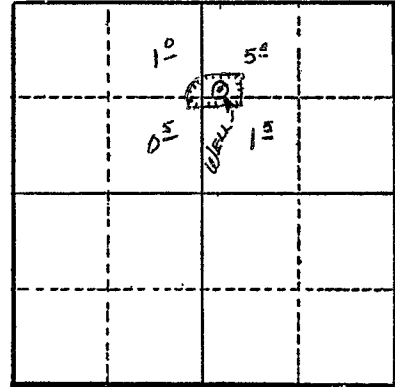

Section 20

Altitude at well _____

TYPE OF WELL: Drilled Date Constructed 1951

Depth drilled 45' Depth cased 45'

CASING RECORD:

6"

FINISH:

AQUIFERS:

Sand & gravel

WATER LEVEL:

14'

PUMPING EQUIPMENT: Type Jacuzzi jet

H.P. 3

Capacity 120 G.P.M.

WELL TESTS:

Drawdown _____ ft. after _____ hours _____ G.P.M.

Drawdown _____ ft. after _____ hours _____ G.P.M.

USE OF WATER Irrigation Temp. _____ °F. _____, 19_____

SOURCE OF INFORMATION GR Record

DRILLER or DIGGER _____

ADDITIONAL DATA:

Log N.A. Water Level Measurements _____ Chemical Analysis _____ Aquifer Test _____

REMARKS:

Irrigation of 8 acres.