

STATE ENGINEER
Salem, Oregon

Well Record

Polk
1127

STATE WELL NO. 6/3W-29B
COUNTY Polk
APPLICATION NO. GR-1621

GR- 1579

OWNER: Henry J. Neiger

MAILING ADDRESS: Rt. 1, Box 447

LOCATION OF WELL: Owner's No.

CITY AND STATE: Salem, Oregon

NW 1/4 NE 1/4 Sec. 29 T. 6 N. S., R. 3 W., W.M.


Bearing and distance from section or subdivision corner S. 26° 30' E. 1600' from SE cor. of C.C.

Walker DLC.

Altitude at well 80'

TYPE OF WELL: Drilled Date Constructed 1942

Depth drilled 29' Depth cased 29'

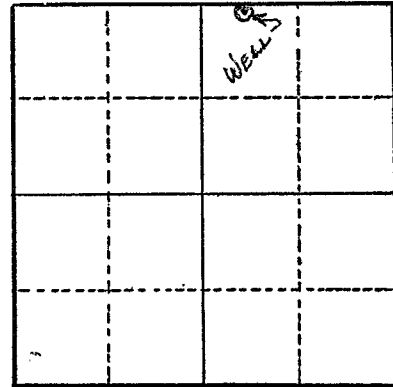

Section 29

CASING RECORD:

8"

FINISH:

8 perforations per ft. 3/8" dia. from 12 to 19 ft.
25 " " " " " " " 19 to 29 ft.

AQUIFERS:

WATER LEVEL:

8'

PUMPING EQUIPMENT: Type Rain-O-Flow 2 1/2" x 2" Cent. H.P. 7 1/2

Capacity 200 G.P.M.

WELL TESTS:

Drawdown _____ ft. after _____ hours _____ G.P.M.
Drawdown _____ ft. after _____ hours _____ G.P.M.

USE OF WATER Irrigation Temp. _____ °F. _____, 19.

SOURCE OF INFORMATION GR Record

DRILLER or DIGGER Fred Wymore

ADDITIONAL DATA:

Log _____ Water Level Measurements _____ Chemical Analysis _____ Aquifer Test _____

REMARKS:

Log: Wash in dirt 0 to 18 ft.
Sand 18 to 19 ft.
Gravel 19 to 29 ft.

Irrigation of 33.7 acres.