


STATE ENGINEER
Salem, Oregon

Well Record

9138 Polk
STATE WELL NO. 6/3W-30R(1)
COUNTY Polk
APPLICATION NO. GR-288

OWNER: Nick J. Nelke
MAILING ADDRESS: Rt. 1, Box 732
CITY AND STATE: Salem, Oregon

LOCATION OF WELL: Owner's No. 1
SE 1/4 SE 1/4 Sec. 30 T. 6 S., R. 3 W., W.M.
Bearing and distance from section or subdivision
corner 1000' N. & 500' W. from SE cor. Sec. 30

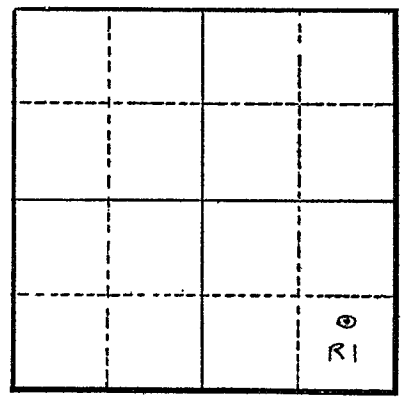

Altitude at well 172 ft. Interpolated

TYPE OF WELL: drilled Date Constructed April, 1952

Depth drilled 77 1/2 Depth cased 77 1/2

Section 30

CASING RECORD: 8 inch steel casing from 0 to 77 1/2 feet

FINISH: Perforations from 42 to 77 ft.

AQUIFERS: unknown

WATER LEVEL: 52 1/2 feet below land surface

PUMPING EQUIPMENT: Type Berkeley turbine H.P. 15
Capacity 300 G.P.M.

WELL TESTS:
Drawdown 70 ft. after _____ hours pumping 350 G.P.M.
Drawdown 49 ft. after _____ hours " 250 G.P.M.

USE OF WATER irrigation 35 acres Temp. _____ °F., 19

SOURCE OF INFORMATION Reg. Statement GR-261

DRILLER or DIGGER Wilcox Drilling Co.

ADDITIONAL DATA:
Log No Water Level Measurements _____ Chemical Analysis _____ Aquifer Test _____

REMARKS: Water bearing zone between 53 and 77 ft. (24 ft. thick)