

STATE ENGINEER
Salem, Oregon

Well Record

Polk
1939


STATE WELL NO. 6/3-31J
COUNTY Polk
APPLICATION NO. GR-2080

OWNER: W. A. Byers MAILING ADDRESS: Rt. 1, Box 407

LOCATION OF WELL: Owner's No. _____ CITY AND STATE: Salem, Oregon

NE $\frac{1}{4}$ SE $\frac{1}{4}$ Sec. 31 T. 6 N. S., R. 3 E. W., W.M.

Bearing and distance from section or subdivision corner 450' W. & 350' S.

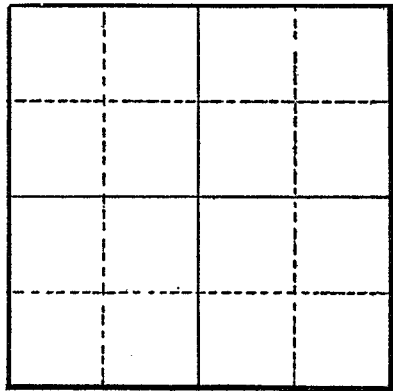

Section _____

Altitude at well _____

TYPE OF WELL: Bored Date Constructed 1953

Depth drilled 66 ft. Depth cased 66 to 77 ft.

CASING RECORD: 10 inch

FINISH: Perforations from bottom to 64 ft.

AQUIFERS: Clay & shale

WATER LEVEL: 10 ft.

PUMPING EQUIPMENT: Type Fairbanks Morse turbine H.P. 15
Capacity 200 G.P.M.

WELL TESTS:
Drawdown 61 ft. after _____ hours pumping 420 G.P.M.
Drawdown 54 ft. after _____ hours pumping 380 G.P.M.

USE OF WATER irrigation Temp. _____ °F., 19_____

SOURCE OF INFORMATION GR-1999

DRILLER or DIGGER Perkins

ADDITIONAL DATA:
Log X Water Level Measurements _____ Chemical Analysis _____ Aquifer Test _____

REMARKS:

