

STATE ENGINEER
Salem, Oregon


Well Record *Polk 1161*

STATE WELL NO. 6/3W-32J
COUNTY Polk
APPLICATION NO. GR-3982

OWNER: Virginia E. Claggett
MAILING ADDRESS: Route 1, Box 403

LOCATION OF WELL: Owner's No. _____
CITY AND STATE: Salem, Oregon

NE 1/4 SE 1/4 Sec. 32 T. 6 S., R. 3 W., W.M.
Bearing and distance from section or subdivision
corner N. 1450' and W. 860' from SE. Cor. Sec. 32

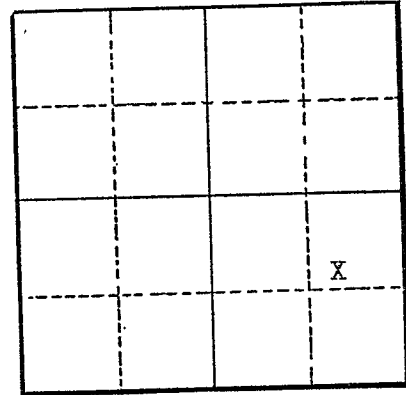

Section 32

Altitude at well _____

TYPE OF WELL: Drilled Date Constructed 5/2/54

Depth drilled 62 ft. Depth cased 62 ft.

CASING RECORD:

6 inch casing set to 62 feet

FINISH:

6 inch standard perforations from 37 to 62 feet

AQUIFERS:

WATER LEVEL:

37 feet below surface

PUMPING EQUIPMENT: Type Jacuzzi jet H.P. 3/4
Capacity 20 G.P.M.

WELL TESTS:

Drawdown _____ ft. after _____ hours _____ G.P.M.
Drawdown _____ ft. after _____ hours _____ G.P.M.

USE OF WATER Irrigation Temp. _____ °F., 19 _____
SOURCE OF INFORMATION Well Registration Statement Cert. # GR-3596

DRILLER or DIGGER _____

ADDITIONAL DATA:

Log _____ Water Level Measurements _____ Chemical Analysis _____ Aquifer Test _____

REMARKS: