

STATE ENGINEER  
Salem, Oregon

# Well Record


*Polk* STATE WELL NO. 6/4W-21Q  
*1203* COUNTY POLK  
~~APPLICATION NO. GR-2867~~

OWNER: Beryl G. Bagley MAILING ADDRESS: Rt. 1, Box 215

LOCATION OF WELL: Owner's No. \_\_\_\_\_ CITY AND STATE: Rickreall, Oregon

SW 1/4 SE 1/4 Sec. 21 T. 6 N. 4 E. W.M.

Bearing and distance from section or subdivision corner 925' E. and 26' S. from the SW corner of Amos Harvey D.L.C. No. 44

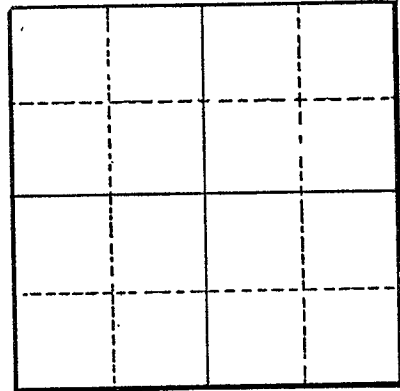

Section \_\_\_\_\_

Altitude at well \_\_\_\_\_

TYPE OF WELL: DRILLED Date Constructed 1947

Depth drilled 60' Depth cased 40'

### CASING RECORD:

6-inch

### FINISH:

### AQUIFERS:

Topsoil, clay, shale and limestone

### WATER LEVEL:

PUMPING EQUIPMENT: Type Jacuzzi H.P. 7 1/2  
Capacity 120 G.P.M.

WELL TESTS:  
Drawdown ? ft. after \_\_\_\_\_ hours Pumping 120 G.P.M.  
Drawdown \_\_\_\_\_ ft. after \_\_\_\_\_ hours \_\_\_\_\_ G.P.M.

USE OF WATER Irrigation Temp. \_\_\_\_\_ °F. \_\_\_\_\_, 19\_\_\_\_

SOURCE OF INFORMATION GR-2701  
DRILLER or DIGGER Marion West, 4120 Market St., Salem, Oregon

ADDITIONAL DATA:  
Log X Water Level Measurements \_\_\_\_\_ Chemical Analysis \_\_\_\_\_ Aquifer Test \_\_\_\_\_

### REMARKS:

Topsoil and clay 10' 10'  
Blue Shale 45' 55'  
White Limestone - Water Bearing 5' 60' ?