


Polk
1238

OWNER: Minerva M. & Homer Lisenby MAILING ADDRESS: 3750 Wilton Ave.

LOCATION OF WELL: Owner's No. 1 CITY AND STATE: Salem, Oregon

NW 1/4 NE 1/4 Sec. 25 T. 6 S., R. 4 W., W.M.
Bearing and distance from section or subdivision
corner 265' S. & 110' E. from N.E. cor. Sec. 25

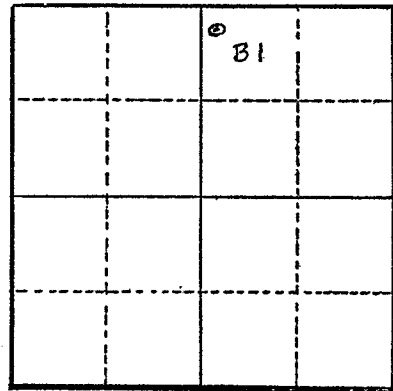

Section 25

Altitude at well 220' Interpolated

TYPE OF WELL: drilled Date Constructed 4/15/52

Depth drilled 117 ft. Depth cased

CASING RECORD: 6 inch

FINISH:

AQUIFERS:

WATER LEVEL: 15 ft.

PUMPING EQUIPMENT: Type H.P. 5
Capacity G.P.M.

WELL TESTS:
Drawdown ft. after hours G.P.M.
Drawdown ft. after hours G.P.M.

USE OF WATER irrigation 19 ac. Temp. °F. 19

SOURCE OF INFORMATION GR-561

DRILLER or DIGGER

ADDITIONAL DATA:
Log Water Level Measurements Chemical Analysis Aquifer Test

REMARKS: Soil, clay 15 ft.
Rock 15 ft. to 30 ft.