

STATE ENGINEER  
Salem, Oregon

Well Record *Polk* STATE WELL NO. 6/LW-36D  
COUNTY Polk  
*1289* APPLICATION NO. GR-3313

OWNER: Herbert A. Miller


MAILING ADDRESS: Route 1, Box 752

LOCATION OF WELL: Owner's No. \_\_\_\_\_

CITY AND STATE: Salem, Oregon

NW  $\frac{1}{4}$  NW  $\frac{1}{4}$  Sec. 36 T. 6 <sup>N.</sup> S., R. 4 <sup>E.</sup> W., W.M.

Bearing and distance from section or subdivision corner 1350' N. 600' E.

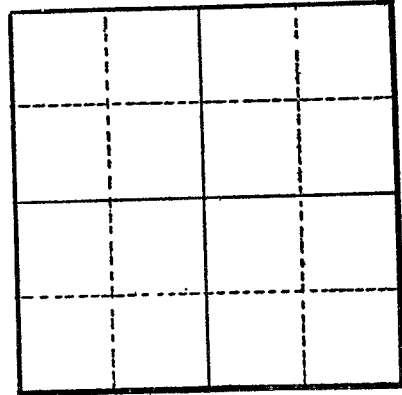

Section \_\_\_\_\_

Altitude at well \_\_\_\_\_

TYPE OF WELL: drilled Date Constructed 1948

Depth drilled 87' Depth cased 35'

CASING RECORD:

8"

FINISH:

AQUIFERS:

WATER LEVEL:

35'

PUMPING EQUIPMENT: Type General Electric  $1\frac{1}{2}$  inch H.P. 2  
Capacity 75 G.P.M.

WELL TESTS:

Drawdown 25 ft. after \_\_\_\_\_ hours pumping 25 G.P.M.

Drawdown \_\_\_\_\_ ft. after \_\_\_\_\_ hours \_\_\_\_\_ G.P.M.

USE OF WATER Irrigation Temp. \_\_\_\_\_ °F., 19 \_\_\_\_\_

SOURCE OF INFORMATION GR-3075

DRILLER or DIGGER \_\_\_\_\_

ADDITIONAL DATA:

Log \_\_\_\_\_ Water Level Measurements \_\_\_\_\_ Chemical Analysis \_\_\_\_\_ Aquifer Test \_\_\_\_\_

REMARKS: