

OWNER: Walter W. Schuerch


MAILING ADDRESS: Rt. 1

LOCATION OF WELL: Owner's No.

CITY AND STATE: Willamina, Oregon

NE 1/4 SE 1/4 Sec. 14 T. 6 N. S., R. 7 E. W., W.M.

Bearing and distance from section or subdivision corner 1150' W. and 2200' N.

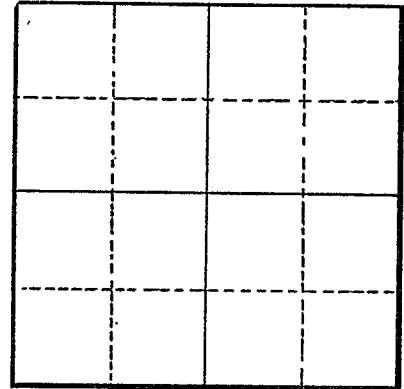

Section

Altitude at well

TYPE OF WELL: Drilled & Date Constructed 1952

Depth drilled 16 1/2 Dug Depth cased 14

CASING RECORD:

48-Inch

FINISH:

AQUIFERS:

Rock, gravel and soil

WATER LEVEL:

8-Feet

PUMPING EQUIPMENT: Type Wards Jet Capacity 10 G.P.M.

H.P.

WELL TESTS:

Drawdown ft. after hours Pumping 6 G.P.M.
Drawdown ft. after hours G.P.M.

USE OF WATER IRRIGATION Temp. °F., 19

SOURCE OF INFORMATION GR-2132

DRILLER or DIGGER

ADDITIONAL DATA:

Log X Water Level Measurements Chemical Analysis Aquifer Test

REMARKS:

Soil 6
Gravel 8
Bed rock 2 1/2