

STATE ENGINEER
Salem, Oregon

Polk
1566

Well Record

STATE WELL NO. 7/3W40
COUNTY Polk
APPLICATION NO. GR-1790

GR-1732 6-6481

OWNER: Leonard Kinkaid
MAILING ADDRESS: 3555 River Bend Rd.

LOCATION OF WELL: Owner's No. CITY AND STATE: Salem, Oregon


SW 1/4 SE 1/4 Sec. 4 T. 7 S., R. 3 W., W.M.

Bearing and distance from section or subdivision corner 563' N. & 580' E. from S¹ cor. Sec. 4

Altitude at well

TYPE OF WELL: Drilled Date Constructed 1936

Depth drilled 40' Depth cased 40'

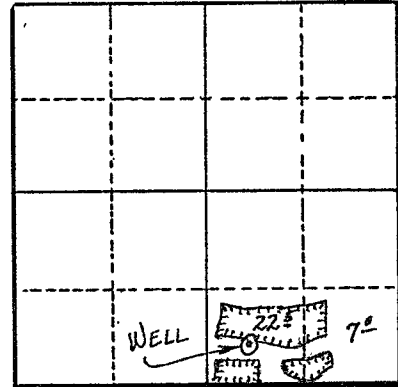

Section 4

CASING RECORD:
8"

FINISH:

AQUIFERS:

WATER LEVEL:
2'

PUMPING EQUIPMENT: Type F. M. Cent. H.P. 10
Capacity 350 G.P.M.

WELL TESTS:
Drawdown 6 ft. after hours 260 G.P.M.
Drawdown ft. after hours G.P.M.

USE OF WATER Irrigation Temp. °F. 19

SOURCE OF INFORMATION GR Record

DRILLER or DIGGER West Well Drilling

ADDITIONAL DATA:
Log N.A. Water Level Measurements Chemical Analysis Aquifer Test

REMARKS:
Irrigation of 29.5 acres.