

STATE ENGINEER  
Salem, Oregon

# Well Record

Polk  
1668


STATE WELL NO. 7/3W-9B  
COUNTY Polk  
APPLICATION NO. GR-3257

OWNER: Billy J. Towery  
MAILING ADDRESS: Route 1, Box 379

LOCATION OF WELL: Owner's No. #1  
CITY AND STATE: Salem, Oregon

NW 1/4 NE 1/4 Sec. 9 T. 7 N. S., R. 3 E. W., W.M.

Bearing and distance from section or subdivision corner  
1150' E. and 250' S. of the S 1/4 corner of Section 4

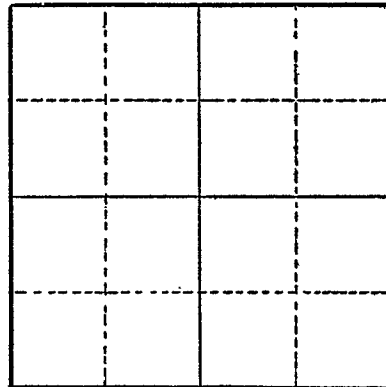

Section

Altitude at well

TYPE OF WELL: drilled Date Constructed 1953

Depth drilled 26 Depth cased 26

### CASING RECORD:

8 inch

### FINISH:

3 per foot 1/2" x 6" slots from 10' to 26'

### AQUIFERS:

Sand and gravel

### WATER LEVEL:

6 feet

PUMPING EQUIPMENT: Type Weinman Centrifugal H.P. 40  
Capacity 700 G.P.M.

### WELL TESTS:

Drawdown 10 ft. after hours Pumping 700 G.P.M.

Drawdown ft. after hours G.P.M.

USE OF WATER Irrigation Temp. °F., 19

SOURCE OF INFORMATION GR-3030

DRILLER or DIGGER Marion West, Market Street, Salem, Oregon

### ADDITIONAL DATA:

Log  Water Level Measurements  Chemical Analysis  Aquifer Test

### REMARKS:

Sand and gravel	0	6	6
Water gravel	6	26	20