

STATE ENGINEER
Salem, Oregon

Well Record


Polk STATE WELL NO. 7/3W-9D
1670 COUNTY Polk
APPLICATION NO. GR-3258

OWNER: Billy J. Towery MAILING ADDRESS: Route 1, Box 379

LOCATION OF WELL: Owner's No. CITY AND STATE: Salem, Oregon

NW 1/4 NW 1/4 Sec. 9 T. 7 S., R. 3 W., W.M.

Bearing and distance from section or subdivision corner 1070' E. of the N.W. corner of Sec. 9

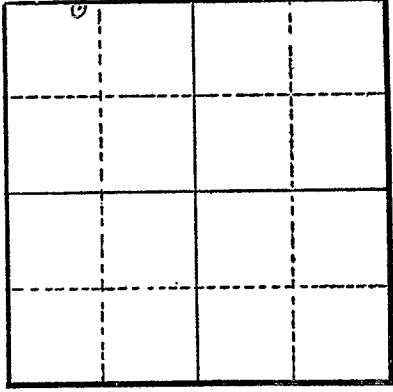

Section

Altitude at well

TYPE OF WELL: drilled Date Constructed 1955

Depth drilled 33 Depth cased 33

CASING RECORD:

8 inch

FINISH:

16 per foot 3/8" x 1 1/4" from 15' to 33'

AQUIFERS:

Soil, sand, and gravel

WATER LEVEL:

12 feet

PUMPING EQUIPMENT: Type Fairbanks Cent. H.P. 20
Capacity 500 G.P.M.

WELL TESTS:
Drawdown 6 ft. after hours Pumping 500 G.P.M.
Drawdown ft. after hours G.P.M.

USE OF WATER Irrigation Temp. °F., 19.....

SOURCE OF INFORMATION GR-3031

DRILLER or DIGGER Marion West, Market Street, Salem, Oregon

ADDITIONAL DATA:
Log Water Level Measurements Chemical Analysis Aquifer Test

REMARKS:

Sub soil	0	8	8
Sand and gravel	8	28	20
Water gravel	28	33	5