

STATE ENGINEER  
Salem, Oregon

# Well Record

*Polk*  
STATE WELL NO. *7/3W-9H*  
COUNTY *Polk*  
APPLICATION NO. *GR-1436*

GR- 1390

OWNER: *Archie Ernest Pelker*


MAILING ADDRESS: *3215 River Bend Rd.*

LOCATION OF WELL: Owner's No. ....

CITY AND STATE: *Salem, Oregon*

*SE* ¼ *NE* ¼ Sec. *9* T. *7* N. S, R. *3* E. W., W.M.

Bearing and distance from section or subdivision corner *740' N. & 1140' W. from SE cor. SE ¼ NE ¼*

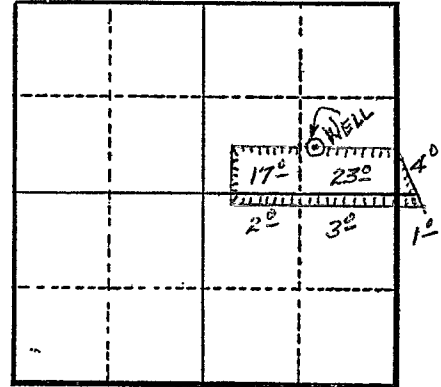

Section *9*

Altitude at well .....

TYPE OF WELL: *Drilled* Date Constructed *1953*

Depth drilled *74.5'* Depth cased *74.5'*

CASING RECORD:  
*10"*

### FINISH:

*Perforated: 20/ft. (5/16" x 3") total of 1008 from 16' to 72'*

### AQUIFERS:

### WATER LEVEL:

*13'*

PUMPING EQUIPMENT: Type ~~.....~~ *Berkeley turbine* H.P. *40*  
Capacity *800* G.P.M.

### WELL TESTS:

Drawdown *2* ft. after ..... hours *500* G.P.M.  
Drawdown ..... ft. after ..... hours ..... G.P.M.

USE OF WATER *Irrigation* Temp. .... °F. ...., 19.

SOURCE OF INFORMATION *GR Record*

DRILLER or DIGGER *J. A. Sneed & Son*

### ADDITIONAL DATA:

Log ..... Water Level Measurements ..... Chemical Analysis ..... Aquifer Test .....

### REMARKS:

Log: Top soil 0' to 13'  
Dry gravel 13' to 16'  
Gravel (water) 16' to 26'  
Cemented gravel 26' to 28'  
Gravel (water) 28' to 29'  
Cemented gravel 29' to 63'  
Water gravel 63 to 64'  
Cemented gravel 64' to 72'  
Water gravel 72' to 74.5'

*Irrigation of 50 acres.*