

Polk
1682


Well Record

OWNER: H. D. Bradrick
MAILING ADDRESS: 2450 Wallace Rd.

LOCATION OF WELL: Owner's No. 1
CITY AND STATE: Salem, Oregon

SE 1/4 SE 1/4 Sec. 9 T. 7 N. S. R. 3 W., W.M.

Bearing and distance from section or subdivision
corner Beginnin at SE cor. Sec. 9 N. 1090' thence
N. 89°30' W. 235' thence S. 41°21' W. 1238.25'

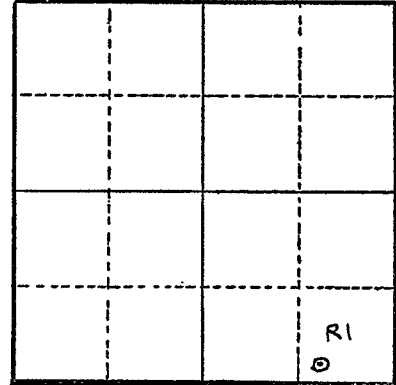

Altitude at well 130 ft.

TYPE OF WELL: drilled Date Constructed April, 1940

Depth drilled 79 ft. Depth cased 79 ft.

Section 9

CASING RECORD: 8 inch

FINISH:

AQUIFERS:

WATER LEVEL: 15 ft.

PUMPING EQUIPMENT: Type Allis Chalmers - Centrifugal H.P. 15
Capacity 325 G.P.M.

WELL TESTS:

Drawdown ft. after hours G.P.M.

Drawdown ft. after hours G.P.M.

USE OF WATER irrigation Temp. °F., 19

SOURCE OF INFORMATION Ground Water Registration Record

DRILLER or DIGGER

ADDITIONAL DATA:

Log No Water Level Measurements Chemical Analysis Aquifer Test

REMARKS: