

Polk  
1683


# Well Record

OWNER: H. D. Bradrick MAILING ADDRESS: \_\_\_\_\_

LOCATION OF WELL: Owner's No. 2 CITY AND STATE: Salem, Oregon

SE 1/4 SE 1/4 Sec. 9 T. 7 N. S, R. 3 E. W., W.M.

Bearing and distance from section or subdivision  
corner Beginning at SE cor. Sec. 9, N. 1090 ft.  
thence N. 89°30' W. 581.65 ft.

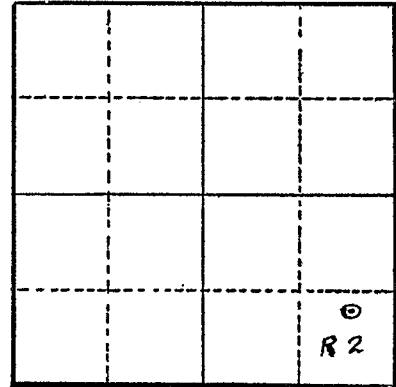

Section 9

Altitude at well \_\_\_\_\_

TYPE OF WELL: drilled Date Constructed May 5, 1955

Depth drilled 83 Depth cased 83

CASING RECORD:

FINISH:

AQUIFERS:

WATER LEVEL: 15

PUMPING EQUIPMENT: Type Centrifugal H.P. 15  
Capacity 350 G.P.M.

WELL TESTS:

Drawdown \_\_\_\_\_ ft. after \_\_\_\_\_ hours \_\_\_\_\_ G.P.M.  
Drawdown \_\_\_\_\_ ft. after \_\_\_\_\_ hours \_\_\_\_\_ G.P.M.

USE OF WATER irrigation Temp. \_\_\_\_\_ °F., 19

SOURCE OF INFORMATION Ground Water Record of Registration

DRILLER or DIGGER \_\_\_\_\_

ADDITIONAL DATA:

Log  Water Level Measurements \_\_\_\_\_ Chemical Analysis \_\_\_\_\_ Aquifer Test \_\_\_\_\_

REMARKS:

