

STATE ENGINEER
Salem, Oregon

Polk
1690

Well Record

STATE WELL NO. 7/3W-10E
COUNTY Polk
APPLICATION NO. GR-1610

GR- 1562

OWNER: Margaret Tschauner Loucks


MAILING ADDRESS: 3030 River Bend Rd.

LOCATION OF WELL: Owner's No.

CITY AND STATE: Salem, Oregon

SW 1/4 NW 1/4 Sec. 10 T. 7 S., R. 3 W., W.M.

Bearing and distance from section or subdivision corner 1930' S. 9° E. from NW cor. Sec. 10.

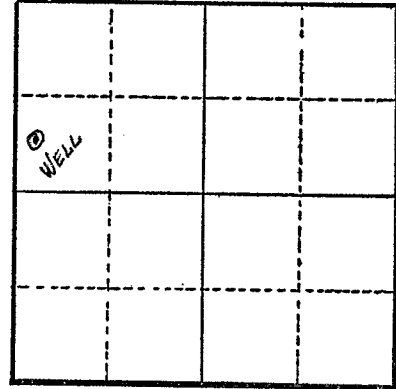

Section 10

Altitude at well 140'

TYPE OF WELL: Drilled Date Constructed 1945

Depth drilled 37' Depth cased 37'

CASING RECORD:

8"

FINISH:

Perforated - 6' ??

AQUIFERS:

WATER LEVEL:

12'

PUMPING EQUIPMENT: Type F. M. 2" Cent. H.P. 20
Capacity 250 G.P.M.

WELL TESTS:

Drawdown 16 ft. after 250 hours G.P.M.

Drawdown ft. after hours G.P.M.

USE OF WATER Irrigation Temp. °F. 19

SOURCE OF INFORMATION GR Record

DRILLER or DIGGER

ADDITIONAL DATA:

Log Water Level Measurements Chemical Analysis Aquifer Test

REMARKS:

Log: Sub soil	0 to 6 ft.
Sand & gravel	6 to 26 ft.
Water gravel	26 to 37 ft.

Irrigation of 19.4 acres.