

STATE ENGINEER
Salem, Oregon

Polk
1691 Well Record

STATE WELL NO. 7/3W-10F
COUNTY Polk
APPLICATION NO. GR-3817
G-4808

B & B FARMS


OWNER: Leland P. Brandt

MAILING ADDRESS: 3095 River Bend Road.

LOCATION OF WELL: Owner's No. _____ CITY AND STATE: Salem, Oregon

SE 1/4 NW 1/4 Sec. 10 T. 7 N. S., R. 3 W. W.M.

Bearing and distance from section or subdivision corner 2250' E. & 2000' S. of the NW Cor. Sec. 10

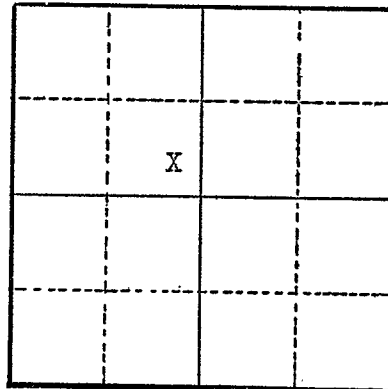

Section 10

Altitude at well _____

TYPE OF WELL: Drilled Date Constructed 1948

Depth drilled 35 feet Depth cased 35 feet

CASING RECORD:

10 inch casing set to 35 feet

FINISH:

perforations about from 18 to 35 feet

AQUIFERS:

WATER LEVEL:

18 feet below surface

PUMPING EQUIPMENT: Type Universal H.P. 15
Capacity 350 G.P.M.

WELL TESTS:

Drawdown 4 ft. after _____ hours 300 G.P.M.

Drawdown _____ ft. after _____ hours _____ G.P.M.

USE OF WATER Irrigation Temp. _____ °F., 19 _____

SOURCE OF INFORMATION Well Registration Statement

DRILLER or DIGGER _____

ADDITIONAL DATA:

Log _____ Water Level Measurements _____ Chemical Analysis _____ Aquifer Test _____

REMARKS: