

ORIGINAL  
File Original and  
Duplicate with the  
STATE ENGINEER,  
SALEM, OREGON

Polk  
1692

RECEIVED

WATER WELL REPORT

State Well No. 7/3W-10 M (1)

STATE OF OREGON

State Permit No. 6690

DEC 5 1957

(1) OWNER:  
Name DOM BLAKE STATE ENGINEER  
Address 2985 RIVER SALEM OREGON

(11) WELL TESTS:  
Drawdown is amount water level is lowered below static level Stetter Supply  
Was a pump test made?  Yes  No If yes, by whom? Salem Or

Yield: 500 gal./min. with 9 ft. drawdown after 1 1/2 hrs.  
" 350 " "2 " "74 "

(2) LOCATION OF WELL:  
County Polk Owner's number, if any— #1  
NW 1/4 SW 1/4 Section 10 T. 7S R. 3W W.M.  
Bearing and distance from section or subdivision corner

Bailer test gal./min. with \_\_\_\_\_ ft. drawdown after \_\_\_\_\_ hrs.  
Artesian flow \_\_\_\_\_ g.p.m. Date \_\_\_\_\_  
Temperature of water 53 Was a chemical analysis made?  Yes  No

South 32°43' East 591 1/2 feet from NW 1/4 corner of Section 10  
\* or 510 1/2 feet west and 353 feet north from SE corner of DLC #70 Lewis Parkhurst.

(12) WELL LOG: Diameter of well 10 inches.  
Depth drilled 42 ft. Depth of completed well 42 ft.  
Formation: Describe by color, character, size of material and structure, and show thickness of aquifers and the kind and nature of the material in each stratum penetrated, with at least one entry for each change of formation.

MATERIAL	FROM	TO
BROWN SANDY LOAM	0	15-
3 INCH-WATER GRAVEL Round	15-	42

TYPE OF WORK (check):  
Well  Deepening  Reconditioning  Abandon   
If abandonment, describe material and procedure in Item 11.

(4) PROPOSED USE (check):  
Domestic  Industrial  Municipal   
Irrigation  Test Well  Other

(5) TYPE OF WELL:  
Rotary  Driven   
Cable  Jetted   
Dug  Bored

(6) CASING INSTALLED: Threaded  Welded   
10" Diam. from 0 ft. to 42 ft. Gage 28 # ft

(7) PERFORATIONS: Perforated?  Yes  No  
Type of perforator used CUTTING TOOL BIT  
SIZE of perforations 1/4 in. by 1/4 in.  
36 perforations from 22 ft. to 42 ft.

SCREENS: Well screen installed  Yes  No  
Manufacturer's Name \_\_\_\_\_  
Type \_\_\_\_\_ Model No. \_\_\_\_\_  
Diam. \_\_\_\_\_ Slot size \_\_\_\_\_ Set from \_\_\_\_\_ ft. to \_\_\_\_\_ ft.  
Diam. \_\_\_\_\_ Slot size \_\_\_\_\_ Set from \_\_\_\_\_ ft. to \_\_\_\_\_ ft.

Work started 12-2 19 57 Completed 12-4 19 57

CONSTRUCTION:  
Well gravel packed?  Yes  No Size of gravel: \_\_\_\_\_  
Gravel placed from \_\_\_\_\_ ft. to \_\_\_\_\_ ft.  
Was a surface seal provided?  Yes  No To what depth? \_\_\_\_\_ ft.  
Material used in seal—  
Did any strata contain unusable water?  Yes  No  
Type of water? \_\_\_\_\_ Depth of strata \_\_\_\_\_  
Method of sealing strata off \_\_\_\_\_

(13) PUMP:  
Manufacturer's Name Peerless  
Type: Turbine H.P. 15 H.P.

Well Driller's Statement:  
This well was drilled under my jurisdiction and this report is true to the best of my knowledge and belief.  
NAME Brendith M. Stecker  
(Person, firm, or corporation) (Type or print)  
Address 1562 Urban Lane  
Driller's well number 2  
[Signed] Brendith M. Stecker  
(Well Driller)  
License No. 225- Date 12-4, 19 57


(10) WATER LEVELS:  
Static level 23.5 ft. below land surface Date 12-4-57  
Artesian pressure \_\_\_\_\_ lbs. per square inch Date \_\_\_\_\_  
Log Accepted by: D F Blake  
[Signed] D F Blake Date 12-4, 19 57  
(Owner)

RECEIVED

JAN 11 1961  
 STATE ENGINEER  
 SALEM, OREGON

Reg. Statement No. GR-2166  
 Certificate of Reg. No. GR-2076

Well was drilled in July, 1960, to save biennial cost of cleaning mud out of sump hole

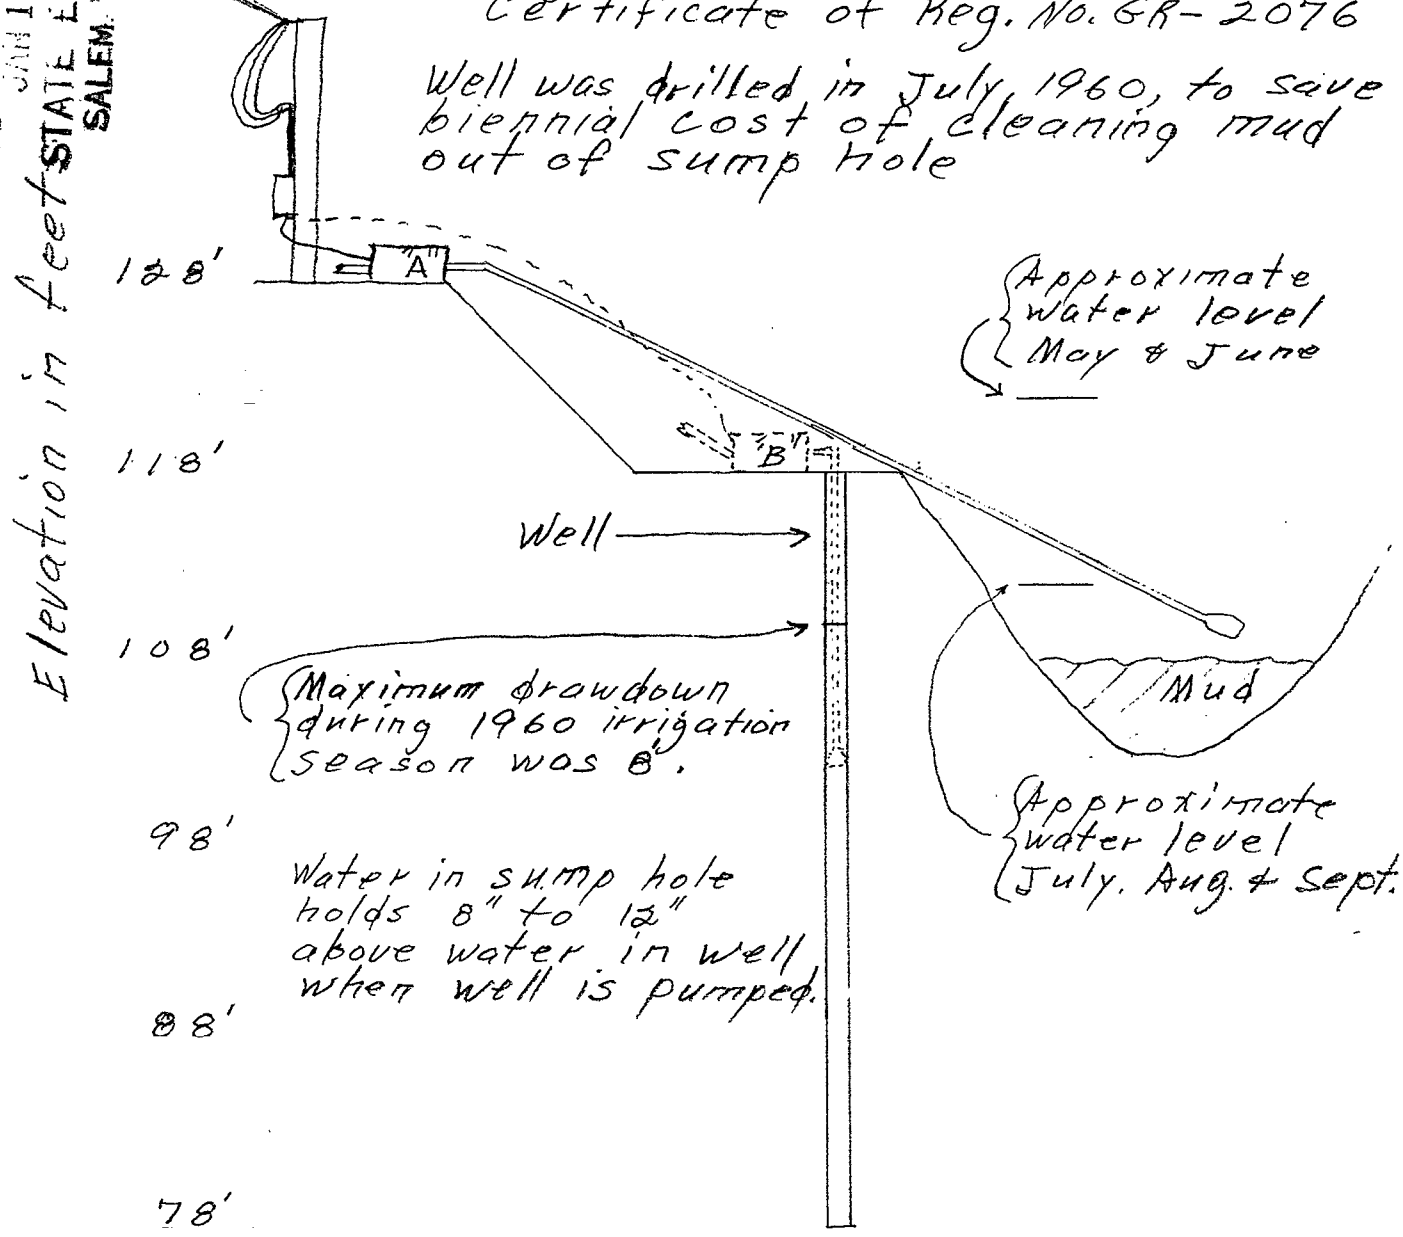

Pump is set at point "A" until sometime in July when it is moved to point "B".

Before well was drilled suction pipe was placed in sump hole, after moving pump to point "B" during July.

Kenneth W. Miller