

STATE ENGINEER  
Salem, Oregon

*Polk  
1694*

# Well Record

GR- 1383

STATE WELL NO. 7/3W-10L  
COUNTY Polk  
APPLICATION NO. GR- 1429

OWNER: Willard Edcheller


MAILING ADDRESS: 2470 River Bend Rd.

LOCATION OF WELL: Owner's No. #3

CITY AND STATE: Salem, Oregon

NE 1/4 SW 1/4 Sec. 10 T. 7 S., R. 3 W., W.M.

Bearing and distance from section or subdivision corner N7°35'E, 1469.1' from pt. which is N70°24'E, 1803.2' from SW cor. Sec. 10.

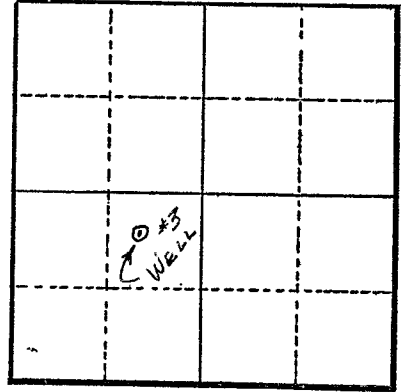

Section 10

Altitude at well 130'

TYPE OF WELL: Drilled Date Constructed 1938

Depth drilled 20' Depth cased 20'

CASING RECORD:

12"

FINISH:

Perforated from 4' to 20'

AQUIFERS:

Gravel

WATER LEVEL:

1'

PUMPING EQUIPMENT: Type Cent.

H.P. 10

Capacity 350 G.P.M.

WELL TESTS:

Drawdown 1 ft. after \_\_\_\_\_ hours 350 G.P.M.

Drawdown \_\_\_\_\_ ft. after \_\_\_\_\_ hours \_\_\_\_\_ G.P.M.

USE OF WATER Irrigation Temp. \_\_\_\_\_ °F., 19

SOURCE OF INFORMATION GR Record

DRILLER or DIGGER \_\_\_\_\_

ADDITIONAL DATA:

Log N.A. Water Level Measurements \_\_\_\_\_ Chemical Analysis \_\_\_\_\_ Aquifer Test \_\_\_\_\_

REMARKS:

Irrigation of 120 acres.