

STATE ENGINEER
Salem, Oregon

*Polk
W-10-10*

Well Record

STATE WELL NO. 7/3W-10P
COUNTY Polk
APPLICATION NO. GR-1428

GR- 1382

OWNER: Willard Bacheller


MAILING ADDRESS: 2470 River Bend Rd.

LOCATION OF WELL: Owner's No. #2

CITY AND STATE: Salem, Oregon

SE 1/4 SW 1/4 Sec. 10 T. 7 S., R. 3 W., W.M.

Bearing and distance from section or subdivision
corner N.24°23'W. 739.5' from pt. which is N70°24'E.
1803.2' from SW cor. Sec. 10.

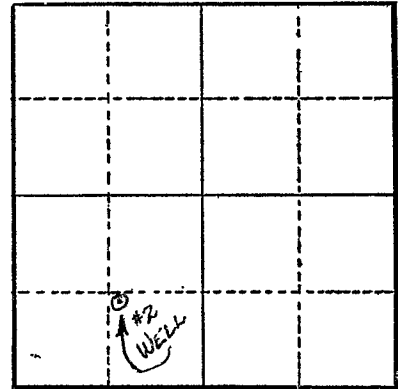

Section 10

Altitude at well 130'

TYPE OF WELL: Drilled Date Constructed 1938

Depth drilled 26' Depth cased 26'

CASING RECORD:
12"

FINISH:

Perforated from 6' to 26'

AQUIFERS:

Gravel

WATER LEVEL:

3'

PUMPING EQUIPMENT: Type Cent. H.P. 20
Capacity 450 G.P.M.

WELL TESTS:

Drawdown 3 ft. after _____ hours 600 G.P.M.
Drawdown _____ ft. after _____ hours _____ G.P.M.

USE OF WATER Irrigation Temp. _____ °F. _____, 19____

SOURCE OF INFORMATION GR Record

DRILLER or DIGGER _____

ADDITIONAL DATA:

Log N.A. Water Level Measurements _____ Chemical Analysis _____ Aquifer Test _____

REMARKS:

Irrigation of 120 acres.