

STATE ENGINEER
Salem, Oregon

Well Record


Polk
1700

STATE WELL NO. 7/3W-15D
COUNTY Polk
APPLICATION NO. GR-4278

OWNER: Minnie J. Cline
MAILING ADDRESS: 2120 River Road NW
CITY AND STATE: Oregon

LOCATION OF WELL: Owner's No. _____
NW 1/4 NW 1/4 Sec. 15 T. 7 N. S. R. 3 E. W., W.M.

Bearing and distance from section or subdivision
corner 600 feet South and 250 feet East
from the NW Corner, Section 15

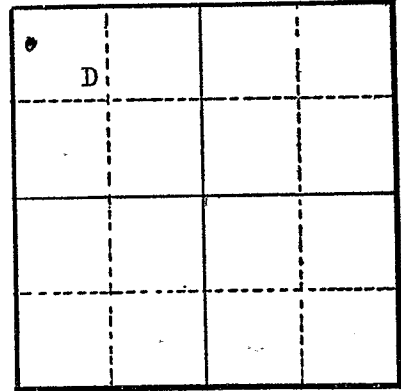

Section 15

Altitude at well _____

TYPE OF WELL: Drilled Date Constructed June 1944

Depth drilled 33 feet Depth cased 33 feet

CASING RECORD:

10-inch steel casing set from 0 to 33 feet

FINISH:

yes, slots cut from 10 to 33 feet

AQUIFERS:

sand and gravel

WATER LEVEL:

10 feet

PUMPING EQUIPMENT: Type Centrifugal H.P. _____
Capacity 450 G.P.M.

WELL TESTS:

Drawdown 10 ft. after _____ hours 450 G.P.M.
Drawdown _____ ft. after _____ hours _____ G.P.M.

USE OF WATER Irrigation Temp. _____ °F. _____, 19

SOURCE OF INFORMATION GR-4130

DRILLER or DIGGER H. Robinson

ADDITIONAL DATA:

Log ^x Water Level Measurements _____ Chemical Analysis _____ Aquifer Test _____

REMARKS:

sand and gravel 30 to 33