

STATE ENGINEER
Salem, Oregon

Well Record


Polk
1710

STATE WELL NO. 7/3W-15D
COUNTY Polk
APPLICATION NO. GR-885

OWNER: Clyde Carpenter
MAILING ADDRESS: 2285 Carpenter Place

LOCATION OF WELL: Owner's No. 1
CITY AND STATE: Salem, Oregon

NW 1/4 NW 1/4 Sec. 15 T. 7 S., R. 3 W., W.M.
Bearing and distance from section or subdivision
corner 1060' E. & 575' S. from NW cor. Sec. 15

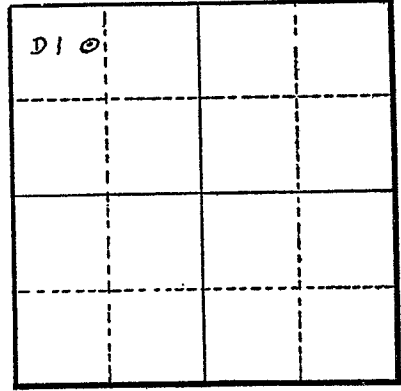

Section 15

Altitude at well 175 ft.

TYPE OF WELL: drilled Date Constructed 1949

Depth drilled 28 ft. Depth cased 28 ft.

CASING RECORD: 10' steel 0 to 28 ft.

FINISH: Perf. 3/8" x 6" torch slots 6 slots per ft. 18 to 27 ft.

AQUIFERS: Sand & gravel

WATER LEVEL: 12 ft.

PUMPING EQUIPMENT: Type Jacuzzi centrifugal 4" H.P. 25 elec.
Capacity 500 G.P.M. U.S. Motor

WELL TESTS:
Drawdown ft. after hours 800 G.P.M.
Drawdown ft. after hours G.P.M.

USE OF WATER Irrigation Temp. °F. 19

SOURCE OF INFORMATION Owner
DRILLER or DIGGER H. Robinson

ADDITIONAL DATA:
Log Water Level Measurements Chemical Analysis Aquifer Test

REMARKS: Log - Sand & gravel 0 to 28 ft.