

STATE ENGINEER
Salem, Oregon

POV 1778
Well Record

STATE WELL NO. 7/3W-15F
COUNTY Polk
APPLICATION NO. GR-887

OWNER: Lena May Carpenter

MAILING ADDRESS: 2285 Carpenter Place


LOCATION OF WELL: Owner's No. 2

CITY AND STATE: Salem, Oregon

SE 1/4 NW 1/4 Sec. 15 T. 7 N. S. R. 3 W., W.M.

Bearing and distance from section or subdivision

corner 1700' E. & 1420' S. from NW cor. Sec. 15

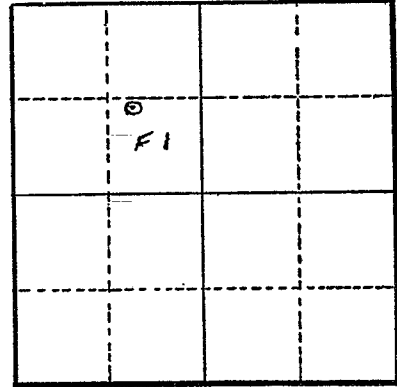

Section 15

Altitude at well 175 ft.

TYPE OF WELL: drilled Date Constructed 1954

Depth drilled 35 Depth cased 35

CASING RECORD: 10 in. steel 0-35'

FINISH: slot perf. 3/8" x 6" 6 perf. 25 to 34 ft.

AQUIFERS: Sand & gravel

WATER LEVEL: 20 ft.

PUMPING EQUIPMENT: Type Fairbanks Morse 4" turbine H.P. 20 elec.
Capacity 400 G.P.M. Fairbanks Morse

WELL TESTS:
Drawdown 2 ft. after hours 460 G.P.M.
Drawdown ft. after hours G.P.M.

USE OF WATER irrigation Temp. °F. , 19

SOURCE OF INFORMATION owner

DRILLER or DIGGER H. Robinson

ADDITIONAL DATA:

Log X Water Level Measurements Chemical Analysis Aquifer Test

REMARKS: Log: Sand & gravel 0 to 35 ft.