

STATE ENGINEER
Salem, Oregon

Polk
1728

Well Record

STATE WELL NO. 7/3W-16F
COUNTY Polk
APPLICATION NO. GR-1391

GR- 1348

OWNER: M. A. Stoutenberg


MAILING ADDRESS: 1102 Redwood St.

LOCATION OF WELL: Owner's No. #1

CITY AND STATE: Salem, Oregon

SE $\frac{1}{4}$ NW $\frac{1}{4}$ Sec. 16 T. 7 XX S., R. 3 XX W., W.M.

Bearing and distance from section or subdivision corner 1370' S. & 200' W. from N $\frac{1}{4}$ cor. Sec. 16

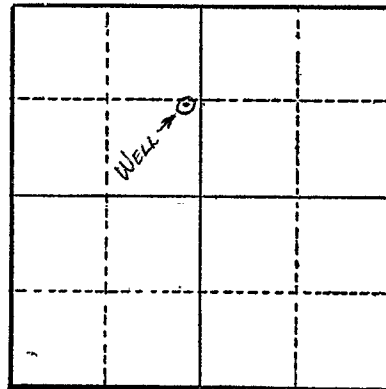

Section 16

Altitude at well 197 ft.

TYPE OF WELL: Drilled Date Constructed 1954

Depth drilled 305 ft. Depth cased 34 ft.

CASING RECORD:

8 inch

FINISH:

AQUIFERS:

WATER LEVEL:

50 ft.

PUMPING EQUIPMENT: Type Berkeley turbine H.P. 15
Capacity 250 G.P.M.

WELL TESTS:

Drawdown ft. after hours G.P.M.
Drawdown ft. after hours G.P.M.

USE OF WATER Group Domestic Temp. °F., 19

SOURCE OF INFORMATION G. R. Record GR-1348

DRILLER or DIGGER Harry A. Robinson

ADDITIONAL DATA:

Log Water Level Measurements Chemical Analysis Aquifer Test

REMARKS:

Log: Soil & clay	0 to 22 ft.
Weathered andesite	22 to 29 ft.
Fresh andesite	29 to 140 ft.
Black shale	140 to 170 ft.
Fresh basalt	170 to 305 ft.