

STATE ENGINEER
Salem, Oregon

Polk
1730


Well Record

STATE WELL NO. 7/3M-160
COUNTY Polk
APPLICATION NO. CR-3503

OWNER: City Water Department MAILING ADDRESS: _____
LOCATION OF WELL: Owner's No. _____ CITY AND STATE: Salem, Oregon

SW 1/4 SE 1/4 Sec. 16 T. 7 ^{N.} S., R. 3 ^{E.} W., W.M.

Bearing and distance from section or subdivision corner S. 1600' W. 665' from NE Cor. Robert Godfrey
D.L.C. # 71

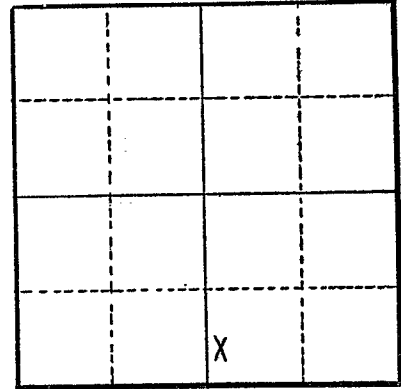

Section 16

Altitude at well _____

TYPE OF WELL: Drilled Date Constructed _____
Depth drilled 165 ft. Depth cased 118 ft.

CASING RECORD:

8 inch casing set to 118 feet

FINISH:

AQUIFERS:

WATER LEVEL:

35 feet below surface

PUMPING EQUIPMENT: Type American Marsh centrifugal H.P. SCV 7 1/2
Capacity 400 G.P.M. GSP 15

WELL TESTS:

Drawdown 65 ft. after _____ hours 390 G.P.M.
Drawdown _____ ft. after _____ hours _____ G.P.M.

USE OF WATER Intermittently Temp. _____ °F., 19 _____

SOURCE OF INFORMATION Well Registration Statement

DRILLER or DIGGER C. A. Witercraft

ADDITIONAL DATA:

Log X Water Level Measurements _____ Chemical Analysis _____ Aquifer Test _____

REMARKS:

Log:	Thickness	Depth to Bottom
Clay, sand & gravel - no water	118	118
Soft rock to hard - no water	42	160
Underground stream or reservoir	5	165