

OBSERVATION WELL

STATE ENGINEER
Salem, Oregon

Well Record


STATE WELL NO. 7/3W-18E(1)
COUNTY Polk
APPLICATION NO. 1787

OWNER: Orchard Heights Water Association
MAILING ADDRESS: Rt. 1, Box 135

LOCATION OF WELL: Owner's No. #1
CITY AND STATE: Salem, Oregon

SW 1/4 NW 1/4 Sec. 18 T. 7 S., R. 3 W., W.M.

Bearing and distance from section or subdivision
corner 4 miles W. of Center St. bridge
on Orchard Heights Rd.

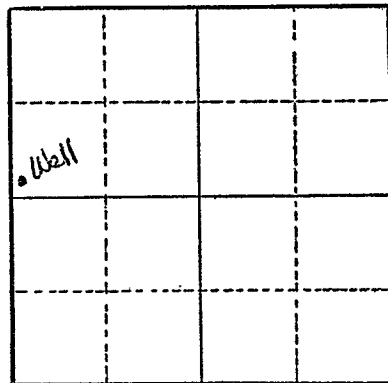

Section 18

Altitude at well 600 ft.

TYPE OF WELL: Drilled Date Constructed 1952

Depth drilled 187' Depth cased 65'

CASING RECORD:
8 inch from top to 65 ft.

FINISH:

AQUIFERS:

WATER LEVEL:
100 ft.

PUMPING EQUIPMENT: Type Berkeley H.P. 7 1/2
Capacity 40 G.P.M.

WELL TESTS:
Drawdown ft. after hours G.P.M.
Drawdown ft. after hours G.P.M.

USE OF WATER Domestic Temp. °F., 19

SOURCE OF INFORMATION Related registration statement

DRILLER or DIGGER Studebaker Bros.

ADDITIONAL DATA:
Log Water Level Measurements Chemical Analysis Aquifer Test

REMARKS: