


STATE ENGINEER  
Salem, Oregon

Well Record **Polk** STATE WELL NO. **7/3W-20G**  
**1834** COUNTY **Polk**  
APPLICATION NO. **GR-3617**

OWNER: Rollin & Myrtle J. Beaver MAILING ADDRESS: Route 1, Box 63

LOCATION OF WELL: Owner's No. \_\_\_\_\_ CITY AND STATE: Salem, Oregon

SW  $\frac{1}{4}$  NE  $\frac{1}{4}$  Sec. 20 T. 7 S., R. 3 W., W.M.  
Bearing and distance from section or subdivision  
corner N. 3° E. 240.0' & 65.0' W. from the NE  
corner of Blk 2 of Burley Fruit Farms.

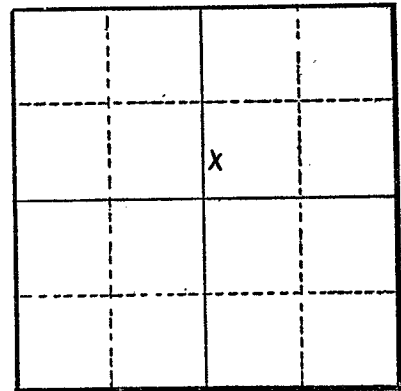

Section 20

Altitude at well \_\_\_\_\_

TYPE OF WELL: drilled Date Constructed May, 1954  
Depth drilled 75 feet Depth cased 60 feet

CASING RECORD:

6 inch casing set to 60 feet

FINISH:

perforation longitudinal from 40 to 60 feet

AQUIFERS:

WATER LEVEL:

35 feet below surface

PUMPING EQUIPMENT: Type Fairbanks Morse Piston type H.P. 1  
Capacity 8 G.P.M.

WELL TESTS:

Drawdown 35 ft. after \_\_\_\_\_ hours 720 G.P.M.  
Drawdown \_\_\_\_\_ ft. after \_\_\_\_\_ hours \_\_\_\_\_ G.P.M.

USE OF WATER Irrigation Temp. \_\_\_\_\_ °F. \_\_\_\_\_, 19\_\_\_\_

SOURCE OF INFORMATION Well Registration Statement

DRILLER or DIGGER R. Sladeli

ADDITIONAL DATA:

Log  Water Level Measurements \_\_\_\_\_ Chemical Analysis \_\_\_\_\_ Aquifer Test \_\_\_\_\_

REMARKS:

Log:  
Clay to about 33 feet, then alluvial material in which water was found,  
then soft rock to 60 feet, then hard basalt.