

STATE ENGINEER
Salem, Oregon

Well Record


Polk
1851 STATE WELL NO. 7/3W-29M
COUNTY Polk
APPLICATION NO. GR-4167

OWNER: Bonneville Power Administration MAILING ADDRESS: P.O. Box 3537

LOCATION OF WELL: Owner's No. _____ CITY AND STATE: Portland 8, Oregon

NW 1/4 SW 1/4 Sec. 29 T. 7 S, R. 3 W., W.M.

Bearing and distance from section or subdivision corner 600' S. & 550' E. of 1/4 Cor. W. line Sec. 29

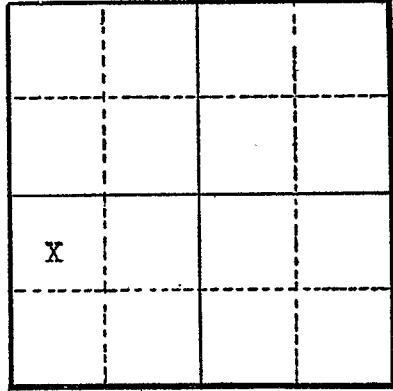

Section 29

Altitude at well _____

TYPE OF WELL: Drilled Date Constructed 4/40

Depth drilled 375 ft. Depth cased 375 ft.

CASING RECORD:

10 inch standard pipe from surface to 129 feet
8 inch standard pipe from 125 to 375 feet

FINISH:

251 ft. of perforated 8" casing from 125 to 375 feet

AQUIFERS:

WATER LEVEL:

51 feet below surface

PUMPING EQUIPMENT: Type Peerless 6" L - 23 stage H.P. 5
Capacity 25 G.P.M.

WELL TESTS:

Drawdown 35 ft. after _____ hours 201 G.P.M.
Drawdown 25 ft. after _____ hours 150 G.P.M.

USE OF WATER Domestic Temp. _____ °F. _____, 19

SOURCE OF INFORMATION Well Registration Statement Cert. # GR-3732

DRILLER or DIGGER _____

ADDITIONAL DATA:

Log X Water Level Measurements _____ Chemical Analysis _____ Aquifer Test _____

REMARKS:

