

STATE ENGINEER  
Salem, Oregon


# Well Record

STATE WELL NO. 7/3W-29Q  
COUNTY ~~Mackay~~ Polk  
APPLICATION NO. GR-3690

OWNER: Rex P. Swearingen  
MAILING ADDRESS: 885 Vista Ave

LOCATION OF WELL: Owner's No. \_\_\_\_\_  
CITY AND STATE: Salem, Oregon

SW  $\frac{1}{4}$  SE  $\frac{1}{4}$  Sec. 29 T. 7 N. S., R. 3 E. W., W.M.  
Bearing and distance from section or subdivision  
corner 3965 feet South and 1300 feet East from  
the N $\frac{1}{4}$  Corner, Section 29.

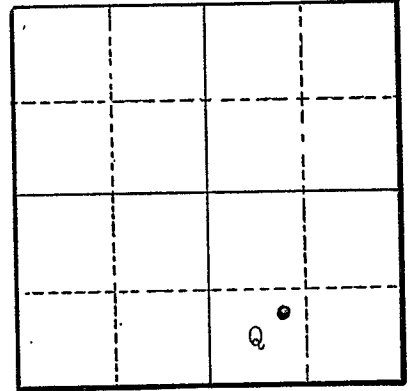

Section 29

Altitude at well \_\_\_\_\_

TYPE OF WELL: Drilled Date Constructed 1949

Depth drilled 33 feet Depth cased 33 feet

### CASING RECORD:

8-inch steel casing set from 0 to 33 feet

### FINISH:

### AQUIFERS:

### WATER LEVEL:

17 feet

PUMPING EQUIPMENT: Type Fairbanks, Centrifugal H.P. \_\_\_\_\_  
Capacity \_\_\_\_\_ G.P.M.

### WELL TESTS:

Drawdown \_\_\_\_\_ ft. after \_\_\_\_\_ hours \_\_\_\_\_ G.P.M.  
Drawdown \_\_\_\_\_ ft. after \_\_\_\_\_ hours \_\_\_\_\_ G.P.M.

USE OF WATER Irrigation Temp. \_\_\_\_\_ °F. \_\_\_\_\_, 19\_\_\_\_

SOURCE OF INFORMATION GR-4084

DRILLER or DIGGER Marion West

### ADDITIONAL DATA:

Log (NA) Water Level Measurements \_\_\_\_\_ Chemical Analysis \_\_\_\_\_ Aquifer Test \_\_\_\_\_

### REMARKS: