

STATE ENGINEER
Salem, Oregon

Well Record


Polk
1956
STATE WELL NO. 7/4W-11H
COUNTY Polk
APPLICATION NO. GR-3270

OWNER: Robert J. Fitts
MAILING ADDRESS: Independence

LOCATION OF WELL: Owner's No. #8
CITY AND STATE: Oregon

SE 1/4 NE 1/4 Sec. 11 T. 7 S., R. 4 W., W.M.

Bearing and distance from section or subdivision corner
1300' W and 2700' S. of Section cor.
1, 2, 11, 12.

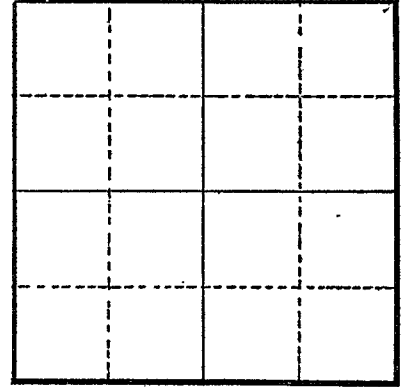

Section

Altitude at well

TYPE OF WELL: drilled Date Constructed before 1935

Depth drilled 30 Depth cased 30

CASING RECORD:

10 inch

FINISH:

AQUIFERS:

WATER LEVEL:

15 - 18 feet

PUMPING EQUIPMENT: Type H.P. 10 - 50
Capacity 200 - 700 G.P.M.

WELL TESTS:

Drawdown ft. after hours G.P.M.
Drawdown ft. after hours G.P.M.

USE OF WATER Irrigation Temp. °F., 19

SOURCE OF INFORMATION GR-3041

DRILLER or DIGGER

ADDITIONAL DATA:

Log Water Level Measurements Chemical Analysis Aquifer Test

REMARKS: