

STATE ENGINEER
Salem, Oregon

Polk
2059

Well Record

STATE WELL NO. 7/4W-24G
COUNTY Polk
APPLICATION NO. GR-3513

OWNER: Roscoe W. Clark


MAILING ADDRESS: Route 1, Box 879

LOCATION OF WELL: Owner's No. _____

CITY AND STATE: Salem, Oregon

SW $\frac{1}{4}$ NE $\frac{1}{4}$ Sec. 24 T. 7 N. S., R. 4 N. W., W.M.

Bearing and distance from section or subdivision corner 49 ch. N. and 21 ch. W.

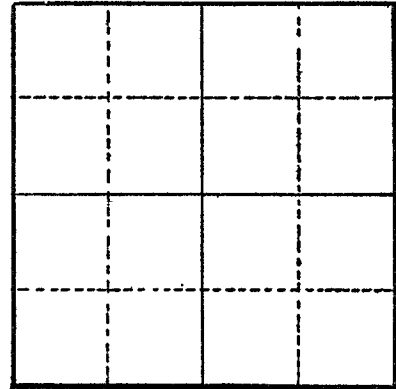

Section _____

Altitude at well _____

TYPE OF WELL: drilled Date Constructed _____

Depth drilled 216' Depth cased 14'

CASING RECORD:

8"

FINISH:

AQUIFERS:

dirt, hard rock

WATER LEVEL:

5'

PUMPING EQUIPMENT: Type Berkeley Cent. H.P. 10
Capacity 100 G.P.M.

WELL TESTS:

Drawdown _____ ft. after _____ hours _____ G.P.M.
Drawdown _____ ft. after _____ hours _____ G.P.M.

USE OF WATER Irrigation Temp. _____ °F. _____, 19 _____

SOURCE OF INFORMATION GR-3231

DRILLER or DIGGER Studebaker moved to California

ADDITIONAL DATA:
Log x Water Level Measurements _____ Chemical Analysis _____ Aquifer Test _____

REMARKS:

dirt 4' 216'
hard rock to bottom +212' 212' 216'